

CODING

Webster
C 10
9-14-68

MISSISSIPPI
BOARD OF WATER COMMISSIONERS
416 North State Street
Jackson, Mississippi 39201

WATER WELL DRILLERS LOG

9-14 1968 Charles Lovern Webster
date well completed firm name county well located

LANDOWNER: C.A. Bengham
~~Esopora~~ Miss.
Maben
(mailing address)

description of formations encountered	from	to
Red clay white sand	0	15 15-120

WELL LOCATION:
sec. 26 T 16 R 10 E
6 miles East of Waltham
(distance) (direction) (nearest town)

WELL PURPOSE: home
(home, irrigation, municipal, industrial)

WELL COMPLETION DATA:
(1) diameter (inches) 4
(2) total depth (feet) 120
(3) static water level (feet) 40 below top of ground.
(4) casing Plastic 120 (material) (depth)

_____ if telescope see back.
(size)

(5) screen _____ (length) _____ (depth to top)
(size) (material)

(6) pump 3/4 7 (HP) (yield gpm)
Electric (type power)

(7) electric log no (yes or no)

_____ (organization running log)

(8) how well bottom plugged Gravel

DRILLERS REMARKS:


FEB 21 1969

MISS. BD. OF
WATER COMMISSIONERS
21 1969

MISS. BD. OF
WATER COMMISSIONERS

If well telescopes please sketch and show depths.

GROUND LEVEL

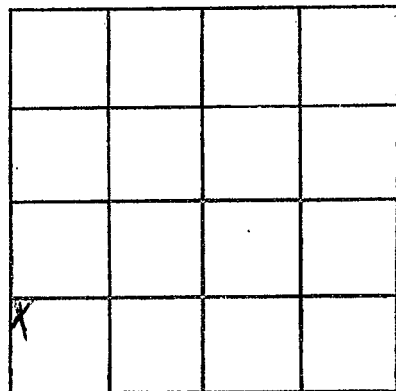

SECTION 26

Please indicate well location X.

ADDITIONAL INFORMATION

If more than one screen,
show locations of each on sketch.