

Webster  
 C 11  
 10-10-68

MISSISSIPPI  
 BOARD OF WATER COMMISSIONERS  
 416 North State Street  
 Jackson, Mississippi 39201

CODED  
 CODED

WATER WELL DRILLERS LOG

10-10 date well completed  
 1968 Charles Lorenson firm name  
 Webster county well located

LANDOWNER: Charles Webster  
 Maken, Miss.  
 (mailing address)

description of formations encountered	from	to
Red clay	0	15
white sand	15	120

WELL LOCATION:  
 sec 26 T-16 R-10E  
 6 miles East of Walthall  
 (distance) (direction) (nearest town)

WELL PURPOSE: home  
 (home, irrigation, municipal, industrial)

- WELL COMPLETION DATA:
- (1) diameter (inches) 4
  - (2) total depth (feet) 120
  - (3) static water level (feet) 40 <sup>below</sup> <sub>above</sub> top of ground.
  - (4) casing Plastic, 120'  
 (material) (depth)
  - \_\_\_\_\_ if telescope see back.  
 (size)
  - (5) screen \_\_\_\_\_  
 (length) (depth to top)
  - \_\_\_\_\_ (size) \_\_\_\_\_ (material)
  - (6) pump 3/4 7  
 (HP) (yield gpm)
  - Electric  
 (type power)
  - (7) electric log no  
 (yes or no)
  - \_\_\_\_\_ (organization running log)
  - (8) how well bottom plugged Gravel


CODED

DRILLERS REMARKS:

FEB 21 1969

If well telescopes please sketch and show depths.

GROUND LEVEL

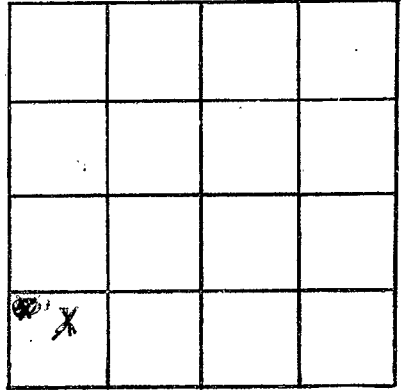

SECTION 26

Please indicate well location X.

ADDITIONAL INFORMATION

If more than one screen, show locations of each on sketch.