

Webster
 C 12
 11-6-68

MISSISSIPPI
 BOARD OF WATER COMMISSIONERS
 416 North State Street
 Jackson, Mississippi 39201



WATER WELL DRILLERS LOG

11-6 1968 Charles Lovern Webster
 date well completed firm name county well located

LANDOWNER: Rayce N. White
 Naben, Miss

description of formations encountered	from	to
Red clay	0	15
Sand & white	15	120

(mailing address)

WELL LOCATION:
 sec. 26 T. 16 N. R. 10 E
 6 miles East of Walnut
 (distance) (direction) (nearest town)

WELL PURPOSE: Home
 (home, irrigation, municipal, industrial)

WELL COMPLETION DATA:
 (1) diameter (inches) 4
 (2) total depth (feet) 120
 (3) static water level (feet) 40 below top of ground.
 (4) casing Plastic, 120 (material), (depth)

(size) if telescope see back.
 (5) screen (length) (depth to top)
 (size) (material)
 (6) pump 3/4 (HP) 7 (yield gpm)

Electric (type power)
 (7) electric log No. (yes or no)

(organization running log)
 (8) how well bottom plugged Gravel


DRILLERS REMARKS:

FEB 21 1968

MISS. BD. OF
 WATER COMM.

If well telescopes please sketch and show depths.

GROUND LEVEL

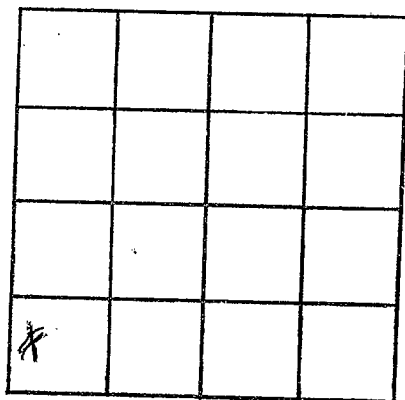

SECTION 26

Please indicate well location X.

ADDITIONAL INFORMATION

If more than one screen,
show locations of each on sketch.