

WEBSTER

C 14

6-67

MISSISSIPPI
 BOARD OF WATER COMMISSIONERS
 416 North State Street
 Jackson, Mississippi 39201

CODED

WATER WELL DRILLERS LOG

6-17

1967

Charles Loren Webster

date well completed

firm name

county well located

LANDOWNER:

D. B. Love

description of formations encountered

from

to

Rt 4

Seaford Miss 39749
(mailing address)

WELL LOCATION:

sec 11 T 16 N

R 10 W

2 miles

SE

Monte Vista

(distance)

(direction)

(nearest town)

WELL PURPOSE:

Home

(home, irrigation, municipal, industrial)

WELL COMPLETION DATA:

(1) diameter (inches)

4"

(2) total depth (feet)

140'

(3) static water level (feet)

60' below top of ground

(4) casing

Plastic 100'

(material)

(depth)

(size)

if telescope see back.

(5) screen

(length)

(depth to top)

(size)

(material)

(6) pump

3/4

(HP)

4 per mi

(yield gpm)

Electric

(type power)

(7) electric log

(yes or no)

(organization running log)

(8) how well bottom plugged

Gravel

DRILLERS REMARKS:


CODED

JUN 17 1967

MISS. Bd. OF WATER COMRL.

If well telescopes please sketch and show depths.

GROUND LEVEL

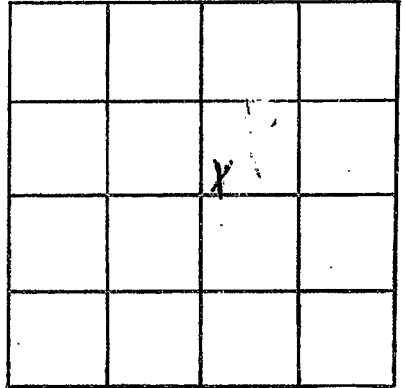

SECTION 11SW

Please indicate well location X.

ADDITIONAL INFORMATION

If more than one screen, show locations of each on sketch.