

Webster
 C15
 3-27-69

MISSISSIPPI
 BOARD OF WATER COMMISSIONERS
 416 North State Street
 Jackson, Mississippi 39201

WATER WELL DRILLERS LOG

3-27 1969 Charles Lovarr Webster
 date well completed firm name county well located

LANDOWNER:

Mrs. A. D. Dickson
Rt 4, Egan, Miss.
 (mailing address)

description of formations encountered

from to

Red Clay	0	10
Blue Sandstone	10	40
Gravel Sand	40	105

WELL LOCATION:

sec. 10 T. 16 N. R. 10 E
1 miles W of Monte Vista
 (distance) (direction) (nearest town)

WELL PURPOSE: Home
 (home, irrigation, municipal, industrial)

WELL COMPLETION DATA:

- (1) diameter (inches) 4"
- (2) total depth (feet) 105'
- (3) static water level (feet) 40' below above top of ground.
- (4) casing Plastic 105'
 (material) (depth)
 (size) if telescope see back.
- (5) screen _____
 (length) (depth to top)
 (size) (material)
- (6) pump 7 7
 (HP) (yield gpm)
Electric
 (type power)
- (7) electric log Yes
 (yes or no)

(organization running log)


(8) how well bottom plugged gravel

DRILLERS REMARKS:

APR 4 - 1969
 MISS. BD. OF
 WATER COMMISSIONERS

If well telescopes please sketch and show depths.

GROUND LEVEL

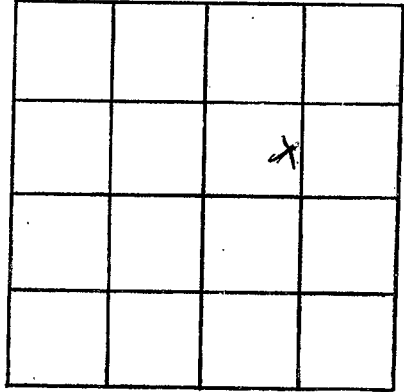

SECTION 105E

Please indicate well location X.

ADDITIONAL INFORMATION

Lined area for additional information.

If more than one screen, show locations of each on sketch.