

CODED  
CODED

Webster  
C 16  
11-25-69

**MISSISSIPPI  
BOARD OF WATER COMMISSIONERS**  
416 North State Street  
Jackson, Mississippi 39201

**WATER WELL DRILLERS LOG**

11-25 1969 Charles Lovorn Webster  
date well completed      firm name      county well located

LANDOWNER: Gma. Vickers  
Rt 2  
Europe, Miss.  
(mailing address)

WELL LOCATION:  
sec. 25 T. 16 N. R. 10 E  
7 miles NE of Walthall Miss.  
(distance)      (direction)      (nearest town)

description of formations encountered	from to	
	ft	ft
<u>Red clay</u>	<u>0</u>	<u>10</u>
<u>Soapstone</u>	<u>10</u>	<u>70</u>
<u>gray sand</u>	<u>70</u>	<u>110</u>

WELL PURPOSE: Home  
(home, irrigation, municipal, industrial)

WELL COMPLETION DATA:

(1) diameter (inches) 4"

(2) total depth (feet) 110'

(3) static water level (feet) 20' <sup>below</sup> above top of ground.

(4) casing Plastic, 110'  
(material) (depth)

\_\_\_\_\_ if telescope see back.  
(size)

(5) screen \_\_\_\_\_ (length) \_\_\_\_\_ (depth to top)

(size) \_\_\_\_\_ (material)

(6) pump Steel \_\_\_\_\_ 9  
(HP) (yield gpm)

Electric  
(type power)

(7) electric log no  
(yes or no)

\_\_\_\_\_ (organization running log)

(8) how well bottom plugged Gravelled


JAN 14 1970

MISS. BD. OF  
WATER COMMISSIONERS

DRILLERS REMARKS:

If well telescopes please sketch and show depths.

GROUND LEVEL

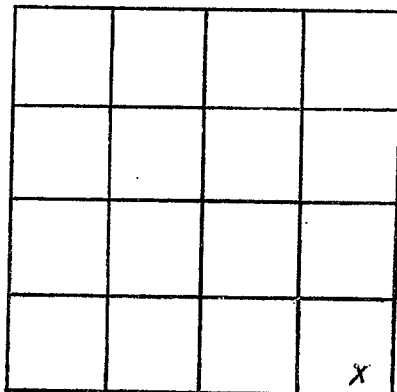

SECTION 25

Please indicate well location X.

ADDITIONAL INFORMATION

If more than one screen, show locations of each on sketch.