

ED 4
1-64

CODED

WATER WELL DRILLERS LOG

Date: June, 1964, Driller: Jack Martin County Holmes
(Name)

(1) Owner of Land	Description & Color of Materials	Thick-ness Feet	Depth Feet
<u>Mrs Charles Harpole</u> (Name) <u>Walthall Miss</u> (Address)	<u>clay</u>	<u>15</u>	<u>15</u>
	<u>mud & sand</u>	<u>16</u>	<u>31</u>
	<u>sand</u>	<u>56</u>	<u>87</u>

(2) Location: 1/4, 28, 16S NE 1/4, Sec. TR,
7 miles NE, of Walthall
(distance) (direction) (Nearest Town)

(3) Topography: Hilly
(Hilly) (Flat) (Level)

(4) Purpose of Well: Domestic
(Domestic Irrigation
Municipal, Industrial, Other)

CODED

coded but
needs loc.
YES
4-11-69

Information upon completion of well:

(1) Diameter 4 inches.

(2) Total Depth 87 feet.

(3) Water Level 28 feet below top of ground.


(4) Cased to 80, Size 4.

(5) Screen: Size 4, Length 7.

(6) Were any formations sealed against pollution?
_____ yes, _____ no.

If YES depth of formation _____
Why _____

Drillers Remarks: _____

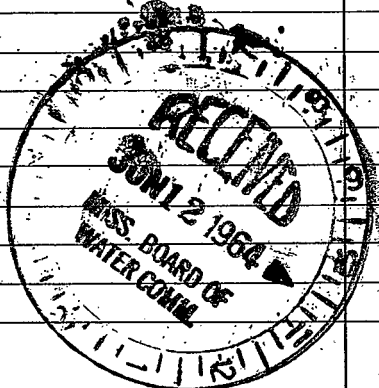

(Use Back Side)

Well No.

1957
JAN 10 1957
1957