

WEBSTER

D 12

WATER WELL DRILLERS LOG

CODED

12-10-62

BLANDON WELL & SUPPLY CO.

Date: Dec 10, 1962, Driller:

P. O. BOX 42

County Webster

SHANNON, MISSISSIPPI

(1) Owner of Land: Floy Skelton
 (Name)
Maples, Miss
 (Address)

(2) Location: 35 155 T. R. 1 E
 (distance) (direction) (Nearest Town)

(3) Topography: Hills
 (Hilly) (Flat) (Level)

(4) Purpose of Well: Domestic
 (Domestic Irrigation
 Municipal, Industrial, Other)

Description & Color of Materials Sand, Clay, Red Clay, Shell, etc.	Thick- ness Feet	Depth Feet
clay		0
to		
Black sand		14
to		15
Black sand		16
to		
White chert		474
to		
Gravel		875
to		
rock		1151
to		
Black sand		1183
to		
Gravel		1120
to		
Black sand		1223
to		
sand		1264
to		
rock		1312
to		
shale		1318
to		
gravel		1337
to		
rock		1353
to		
Black sand		1364
to		
Black sand		1412
to		
rock		1444
to		
Bottom		1445

Information upon completion of well:

(1) Diameter 4 inches.

(2) Total Depth 1449 feet.

(3) Water Level 230 feet below top of ground.
696' 231' 2" 2 1/2"

(4) Cased to 400, Size 4" 2 1/2"


(5) Screen: Size 2, Length 40'

(6) Were any formations sealed against pollution?
 yes, no.

If YES depth of formation 474

Why super & gravel

Drillers Remarks:

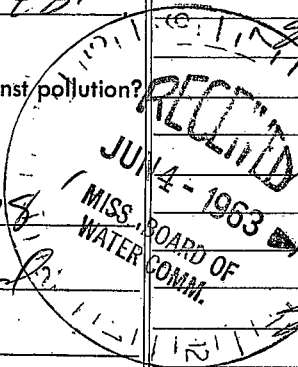

(Use Back Side)

Well No.

