

CODED

MISSISSIPPI BOARD OF WATER COMMISSIONERS  
416 North State Street  
Jackson, Mississippi 39201

WATER WELL DRILLERS LOG

Webster  
D 13  
5-68

5-23 1968 Charles Rowan Webster  
date well completed firm name county well located

LANDOWNER:

Larry Breland  
Escapa, Miss  
(mailing address)

description of formations encountered

from to

Red clay  
sand

0 30  
30 110

WELL LOCATION:

sec. 29 T. 16 N R. 1 E  
2 miles N of Clarksville  
(distance) (direction) (nearest town)

WELL PURPOSE: home  
(home, irrigation, municipal, industrial)

WELL COMPLETION DATA:

(1) diameter (inches) 4"

(2) total depth (feet) 110'

(3) static water level (feet) 25' below top of ground

(4) casing Plastic, 110'  
(material) (depth)

(size) if telescope see back.

(5) screen (length) (depth to top)

(size) (material)

(6) pump 3/4 (HP) 7 (yield gpm)

Edison  
(type power)

(7) electric log no  
(yes or no)

(organization running log)

(8) how well bottom plugged Graded


DRILLERS REMARKS:

CODED

APR 11 8 20 AM '68  
MISS. BOARD OF  
WATER COMM.

If well telescopes please sketch and show depths.

GROUND LEVEL

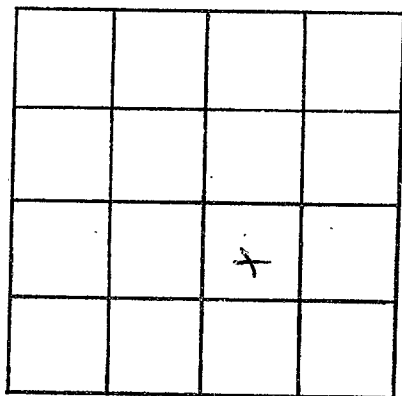

SECTION 29

Please indicate well location X.

ADDITIONAL INFORMATION

If more than one screen,  
show locations of each on sketch.