

Webster
 D 1A
 10 - 63

MISSISSIPPI
 BOARD OF WATER COMMISSIONERS
 416 North State Street
 Jackson, Mississippi 39201

CODED

WATER WELL DRILLERS LOG

Oct. 1963 19 T.M. PARKS DRILG Co. Webster
 date well completed firm name county well located

LANDOWNER: Mantee City
Water Works
Mantee, Miss.
 (mailing address)

description of formations encountered
NOT AVAILABLE

WELL LOCATION:
 sec. 35 T. 16 S R. 2 E
6 miles So. of Mantee
 (distance) (direction) (nearest town)

WELL PURPOSE: Municipal
 (home, irrigation, municipal, industrial)

CODED

WELL COMPLETION DATA:
 (1) diameter (inches) 8"
 (2) total depth (feet) 1698
 (3) static water level (feet) 130 below top of ground.
 (4) casing steel, 4106,
 (material) (depth)
4" if telescope see back.
 (size)
 (5) screen 50, 1648
 (length) (depth to top)
4, stainless
 (size) (material)
 (6) pump 15 100
 (HP) (yield gpm)
3PHASE
 (type power)
 (7) electric log YES (USGS log #)
 (yes or no)
NO
 (organization running log)
 (8) how well bottom plugged BPV

APR 17 1963


MISS. BD. OF
 WATER COMM.

DRILLERS REMARKS:

①

If well telescopes please sketch and show depths.

GROUND LEVEL

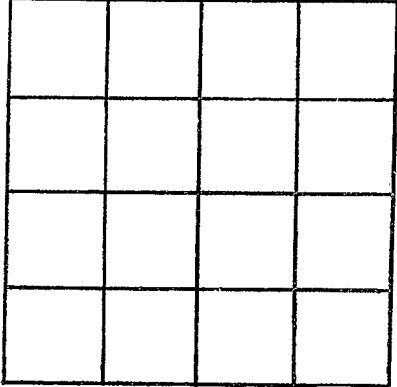

SECTION 35

Please indicate well location X.

ADDITIONAL INFORMATION

A series of horizontal lines for recording additional information.

If more than one screen, show locations of each on sketch.