

E 11
3-16-61

WATER WELL DRILLERS LOG
Herndon Well & Supply Co.
SHANNON, MISS.

COOPER F-300
County Webster

Date: 3/16, 1961, Driller: _____

(Name)

(1) Owner of Land: Marilee Baptist Church
(Name)
Marilee, Mississippi
(Address)

(2) Location: 1/4, 1/4, Sec. 35 T15 R2E
_____ miles _____ of Marilee
(distance) (direction) (Nearest Town)

(3) Topography: Flat
(Hilly) (Flat) (Level)

(4) Purpose of Well: Church
(Domestic Irrigation
Municipal, Industrial, Other)

Description & Color of Materials Sand, Clay, Red Clay, Shell, etc.	Thick- ness Feet	Depth Feet
Brown Clay		28
Black Clay		248
White Limestone		
Gumbo		740
Sand		998
Rock		1100
Sand		1101
Bottom		1131

Information upon completion of well:

(1) Diameter 4 inches.

(2) Total Depth 1131 feet.

(3) Water Level 135 feet below top of ground.

(4) Cased to Bottom, Size 304' of 4" 340' of 2 1/2"


(5) Screen: Size _____ Length _____

(6) Were any formations sealed against pollution?
 yes, _____ no.

If YES depth of formation _____

Why Sand & Gr. Swell

Drillers Remarks: _____

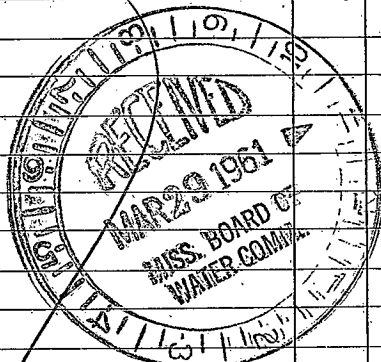

(Use Back Side)

Well No.

