

WEBSTER
G6
7-16-74
E log # 47

MISSISSIPPI
 BOARD OF WATER COMMISSIONERS
 416 North State Street
 Jackson, Mississippi 39201

WATER WELL DRILLERS LOG **CODED**

July 16 1974 Charles Loom Webster
 date well completed firm name county well located

LANDOWNER: <u>Olen Ray</u> <u>Rt 1</u>	description of formations encountered	from	to
<u>Esopus Miss</u> (mailing address)			
WELL LOCATION:			
sec. <u>28</u> <u>200</u> S R. <u>9E</u>			
<u>5</u> miles <u>W.</u> of <u>Esopus Miss</u> (distance) (direction) (nearest town)			
WELL PURPOSE: <u>Home</u> (home, irrigation, municipal, industrial)			
WELL COMPLETION DATA:			
(1) diameter (inches) <u>4"</u>			
(2) total depth (feet) <u>242'</u>			
(3) static water level (feet) <u>120'</u> ^{below} top of ground.			
(4) casing <u>Plastic 202'</u> (material) (depth)			
<u>4"</u> (size) if telescope see back.			
(5) screen <u>40'</u> <u>plastic</u> (length) (depth to top)			
<u>2"</u> <u>plastic</u> (size) (material)			
(6) pump <u>1</u> <u>5</u> (HP) (yield gpm)			
<u>Electric</u> (type power)			
(7) electric log <u>yes</u> (yes/or no)			
<u>USGS</u> (organization running log)			
(8) how well bottom plugged			
DRILLERS REMARKS:			


CODED

RECEIVED

UGI - 8 1974

If well telescopes please sketch and show depths.

GROUND LEVEL

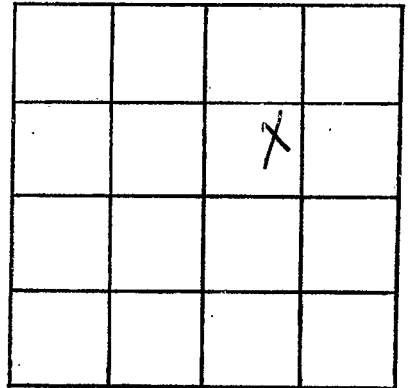

SECTION _____

Please indicate well location X.

ADDITIONAL INFORMATION

If more than one screen,
show locations of each on sketch.