

WEBSTER
G 80
7/31/80
JULY 31 1980

MISSISSIPPI
BOARD OF WATER COMMISSIONERS
416 North State Street
Jackson, Mississippi 39201

CODED

WATER WELL DRILLERS LOG

54
80 J. W. WEBB & SONS WEBSTER

date well completed firm name county well located

LANDOWNER: WEBSTER-
CENTER WATER ASSOC

description of formations encountered	from	to
0-10' RED-CLAY	0	10
SANDY CLAY	10	60
CLAY	60	80
SANDY CLAY	80	110
CLAY	110	150
SANDY CLAY	150	175
SAND	175	200

(mailing address)

WELL LOCATION:
sec. 3 T 20 N R 9 E
3 miles S.W. of BELLEFONTAINE
(distance) (direction) (nearest town)

WELL PURPOSE:
(home, irrigation, municipal, industrial)

WELL COMPLETION DATA:

- (1) diameter (inches) 8"
- (2) total depth (feet) 176'
- (3) static water level (feet) 78' below top of ground.
- (4) casing PLASTIC, 176' (material), (depth)
- (size) If telescope see back.
- (5) screen 20 176 (length), (depth to top)
8" (size), PLASTIC (material)
- (6) pump 15 75 (HP), (yield gpm)
ELEC. (type power)
- (7) electric log YES (yes or no)
S. G. S. (organization running log)
- (8) how well bottom plugged

DEPT. OF NATURAL RESOURCES
BUREAU OF LAND & WATER RESOURCES

FEB 19 1981


RECEIVED

DRILLERS REMARKS:

18

If well telescopes please sketch and show depths.

GROUND LEVEL

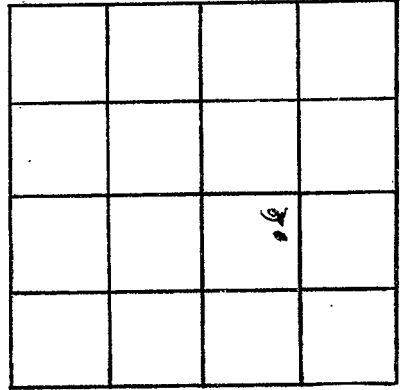

SECTION 3

Please indicate well location X.

ADDITIONAL INFORMATION

A series of horizontal lines for recording additional information, starting below the 'ADDITIONAL INFORMATION' header and extending to the bottom of the page.

If more than one screen, show locations of each on sketch.