

CODED

Webster
G 13
8-2-69

MISSISSIPPI
BOARD OF WATER COMMISSIONERS
416 North State Street
Jackson, Mississippi 39201

WATER WELL DRILLERS LOG

8-2 1969
date well completed

Charles Lockman
firm name

Webster
county well located

LANDOWNER: McGarrh

description of formations encountered

from

to

Fred McGarrh

Rt 1 - Suppa Miss
(mailing address)

Red Clay
Loam Sand
Heavy Sand

0 15
15 97
92 132

WELL LOCATION:

sec 21 T 20 N R 9 E
S W
.04 miles W of Center
(distance) (direction) (nearest town)

WELL PURPOSE:

(home, irrigation, municipal, industrial)

WELL COMPLETION DATA:

- (1) diameter (inches) 4"
- (2) total depth (feet) 132'
- (3) static water level (feet) 30' ^{below} above top of ground.
- (4) casing Plastic, 132'
(material) (depth)
(size) If telescope see back.
- (5) screen (length) (depth to top)
(size) (material)
- (6) pump 3/4 (HP) 9 (yield gpm)
Electric
(type power)
- (7) electric log No
(yes or no)

(organization running log)

(8) how well bottom plugged Open


OCT 6 - 1969

DRILLERS REMARKS:

MISS. BD. OF
WATER COMM.

If well telescopes please sketch and show depths.

GROUND LEVEL

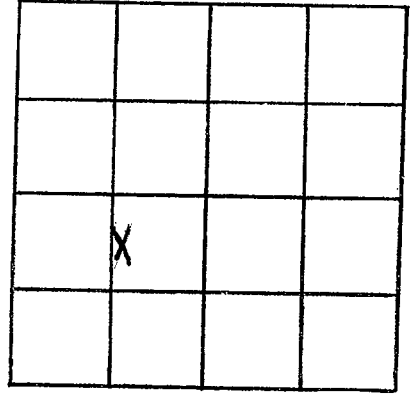

SECTION 21 NE

Please indicate well location X.

ADDITIONAL INFORMATION

Lined area for additional information.

If more than one screen, show locations of each on sketch.