

This looks like the same well as G10

WEBSTER
G16
7/31/80

MISSISSIPPI  
 BOARD OF WATER COMMISSIONERS  
 416 North State Street  
 Jackson, Mississippi 39201

CODED

WATER WELL DRILLERS LOG

July 31 19 80 J W Webb & Sons Webster  
 date well completed firm name county well located

LANDOWNER: Webster- Center Water Assoc.  (mailing address)	description of formations encountered	from	to
		0	10

WELL LOCATION: sec 3 T. 20 N R 9 E S. W. of Fountaine (distance) (direction) (nearest town)	Sandy Clay	10	60
	Clay	60	80
	Sandy Clay	80	110
	Clay	110	150
	Sandy Clay	150	175
	Sand	175	200

WELL PURPOSE: Municipal  
 (home, irrigation, municipal, industrial)


- WELL COMPLETION DATA:
- (1) diameter (inches) 8"
  - (2) total depth (feet) 196'
  - (3) static water level (feet) 78 below top of ground.
  - (4) casing Plastic 176 (material) (depth)  
 \_\_\_\_\_ if telescope see back. (size)
  - (5) screen 20 176 (length) (depth to top)  
 8" Plastic (size) (material)
  - (6) pump 15 75 (HP) (yield gpm)  
 Elect. (type power)
  - (7) electric log yes (yes or no)  
 S.G.S. (organization running log)
  - (8) how well bottom plugged \_\_\_\_\_

CODED

DRILLERS REMARKS:

If well telescopes please sketch and show depths.

GROUND LEVEL

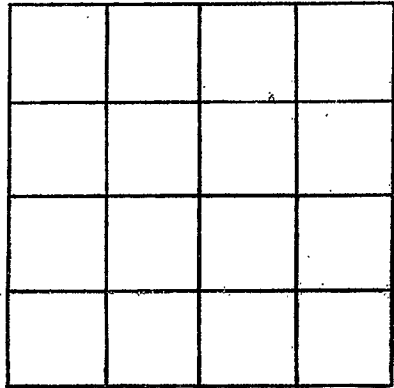

SECTION \_\_\_\_\_

Please indicate well location X.

ADDITIONAL INFORMATION

If more than one screen, show locations of each on sketch.