

WEBSTER

G 2001

4-15-77

MISSISSIPPI BOARD OF WATER COMMISSIONERS
416 North State Street
Jackson, Mississippi 39201

15K

WATER WELL DRILLERS LOG

4-75

19

77 Charles Lovon

Webster

date well completed

firm name

county well located

LANDOWNER:

Jerry Rendall
Rt 3, Europa Mo.
(mailing address)

description of formations encountered

from

to

Clay (Red)	0	20
Blue Shale	20	40
White sand	40	50
Shale	50	154
Blue sand	154	180
" "	180	200
Shale	200	226
Blue sand	226	240

WELL LOCATION:

sec. 8 T. 20 N. R. 10 E. S. 9 ?
6 miles N.W. of Europa Mo.
(distance) (direction) (nearest town)

6 mi NW
of
9E

WELL PURPOSE:

Home
(home, irrigation, municipal, industrial)

WELL COMPLETION DATA:

- (1) diameter (inches) 4"
- (2) total depth (feet) 240'
- (3) static water level (feet) 60' ^{below} _{above} top of ground.
- (4) casing Plastic 200'
(material) (depth)
4x2 (size) if telescope see back.
- (5) screen 40' 200'
(length) (depth to top)
2" (size) plastic (material)
- (6) pump 1 6 gpm
(HP) (yield gpm)
Electric
(type power)
- (7) electric log yes
(yes or no)
State
(organization running log)
- (8) how well bottom plugged Spilled

RECEIVED
NOV 22 1977

DRILLERS REMARKS:


MISS. BD. OF WATER COMM.

If well telescopes please sketch and show depths.

GROUND LEVEL

200'

40'

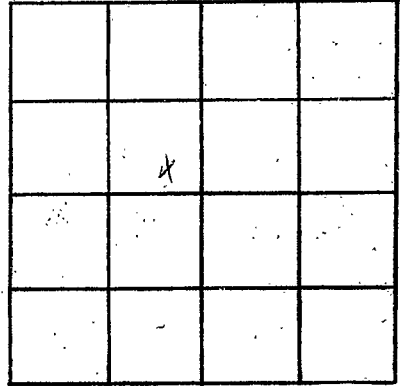

SECTION 8

Please indicate well location X.

ADDITIONAL INFORMATION

If more than one screen, show locations of each on sketch.