

H

WATER WELL DRILLERS LOG

5-30-64

Date: May 30, 1964, Driller: Robert F. Ratliff County Grenada  
 (Name)

27


(1) Owner of Land:	Description & Color of Materials Sand, Clay, Red Clay, Shell, etc.	Thick- ness Feet	Depth Feet
<u>Walthall Development, Family Trust</u> (Name)	<u>Rock</u>	<u>2126</u>	<u>2127</u>
<u>Walthall, Miss</u> (Address)	<u>Shale &amp; sand</u>	<u>2127</u>	<u>2207</u>
(2) Location: <u>1/4</u> , <u>1/4</u> , Sec. <u>T</u> <u>R</u>	<u>Rock</u>	<u>2207</u>	<u>2211</u>
<u>_____</u> miles, of <u>_____</u>	<u>Sand</u>	<u>2211</u>	<u>2212</u>
(distance) (direction) (Nearest Town)	<u>Shale</u>	<u>2212</u>	<u>2285</u>
(3) Topography: _____	<u>Sand</u>	<u>2285</u>	<u>2302</u>
(Hilly) (Flat) (Level)	<u>Sand</u>	<u>2302</u>	<u>2400</u>
(4) Purpose of Well: _____	<u>Sand &amp; shale</u>	<u>2400</u>	<u>2410</u>
(Domestic Irrigation Municipal, Industrial, Other)			

Information upon completion of well:

- (1) Diameter 10 inches.
- (2) Total Depth 2410 feet.
- (3) Water Level 250 feet below top of ground.
- (4) Cased to 2410, Size 10'
- (5) Screen: Size 6", Length 40
- (6) Were any formations sealed against pollution?  
 yes,  no.

If YES depth of formation \_\_\_\_\_  
 Why \_\_\_\_\_

Drillers Remarks: \_\_\_\_\_

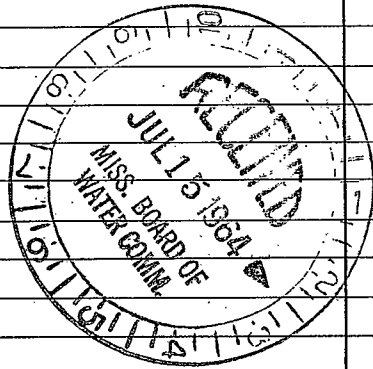

(Use Back Side)

Well No.

Handwritten marks in the top left corner, possibly a date or initials.

Handwritten text in the upper middle section, appearing as a list or set of notes.

Handwritten text in the upper right section.

Handwritten text in the middle right section.

Main body of handwritten text on the left side, organized into several lines.

Handwritten text in the bottom center area, possibly a signature or a date.