

GW-856

coded

Webster

H 10

3-67

Elec Log

MISSISSIPPI
BOARD OF WATER COMMISSIONERS

416 North State Street

Jackson, Mississippi 39201

CODED

WATER WELL DRILLERS LOG

March 1967 19
date well completed

Robert E. Kelly Co.
firm name

Webster
county well located

LANDOWNER:

Mt. Zion
Water Assn.

description of formations
encountered

from

to

Expava, Miss.
(mailing address)

Red Clay	0	24
Red clay + shale	24	46
Blue clay	46	69
Clay + sand	69	92
Sand + Clay streaks	92	115
Shale	115	182
Shale + rocks	182	269
Shale	269	355
Sand	355	369
Shale	369	371

WELL LOCATION:


sec 30 T. 20 N. R. 10 E
S W
2 miles N.W. of Expava
(distance) (direction) (nearest town)

WELL PURPOSE: Municipal
(home, irrigation, municipal, industrial)

WELL COMPLETION DATA:

- (1) diameter (inches) 10 x 6
- (2) total depth (feet) 370
- (3) static water level (feet) 158 ^{below}/_{above} top of ground.
- (4) casing Bl. St. 354'
(material) (depth)
10" (size) if telescope see back.
- (5) screen 16' 354'
(length) (depth to top)
6" 3.5.
(size) (material)
- (6) pump 20 80
(HP) (yield gpm)
El. Motor (type power) (USGS log # 15)
- (7) electric log yes - on test well
(yes or no) (H13)
M. L. S. (organization running log)
- (8) how well bottom plugged BRV.

CODED

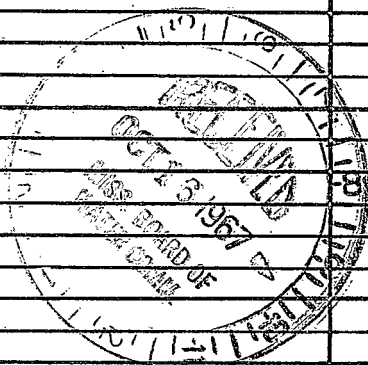

DRILLERS REMARKS:

