

H12
1-27-65

WATER WELL DRILLERS LOG

9699
01901
3/17/65
M


Date: Jan. 27, 1965, Driller: Layne-Central Company County, Webster

(Name)

E Log 11

(1) Owner of Land: Sapa Water Association
(Name)
Eupora, Mississippi
(Address)
(2) Location: NE NW 1/4, Sec. 1 T19N R10E
1 1/2 miles east of Eupora
(distance) (direction) (Nearest Town)
(3) Topography: hilly
(Hilly) (Flat) (Level)
(4) Purpose of Well: municipal
(Domestic Irrigation
Municipal, Industrial, Other)

Description & Color of Materials Sand, Clay, Red Clay, Shell, etc.	Thick- ness Feet	Depth Feet
Sandy clay	25	25
Hard shale	755	780
Lime stone	730	1510
Shale	62	1572
Rock	1	1573
Shale	207	1680
Sandy shale	65	1745
Shale	70	1815
Rock	1	1816
Sandy shale	24	1840
Shale	19	1859
Rock	1	1860
Shale	7	1867
Rock	1	1868
Lime	37	1905
Rock	1	1906
Lime	26	1932
Rock	2	1934
Lime	90	2024
Rock	1	2025
Lime	84	2109
Sand	5	2114
Lime	30	2144
Sand - gravel, hard	97	2241

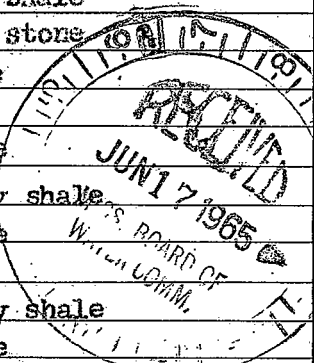

Information upon completion of well:

(1) Diameter 8 1/4 inches.
(2) Total Depth 2198 feet.
(3) Water Level 205 feet below top of ground.
(4) Cased to 600' 549 Size 8"
1585' 4"
(5) Screen: Size 4" Length 60'
2185' 4" BP.V. 3'
2245' Lap 51'
(6) Were any formations sealed against pollution?
2194
yes, yes, no.

If YES depth of formation Mechanical seals,
and cemented.
Why _____

Drillers Remarks: w/l measured
11-30-66 - 196.97 (PEG)
- 2.00 MP
194.97' GL

Well No.

(Use Back Side)

①