

H 15  
2-13-64

WATER WELL DRILLERS LOG

Date: 2-13-, 1964, Driller: Layne-Central Co. County Webster

(Name)

CODED

- (1) Owner of Land: Town of Eupora  
(Name)  
Eupora, Mississippi  
(Address)
- (2) Location: 5 19N 10E  
1/4, 1/4, Sec. T R  
\_\_\_\_\_ miles \_\_\_\_\_ of \_\_\_\_\_  
(distance) (direction) (Nearest Town)
- (3) Topography: \_\_\_\_\_  
(Hilly) (Flat) (Level)
- (4) Purpose of Well: Municipal  
(Domestic Irrigation  
Municipal, Industrial, Other)

Description & Color of Materials Sand, Clay, Red Clay, Shell, etc.	Thick- ness Feet	Depth Feet
clay	13	13
sand, stks clay	13	26
black clay	25	51
gray clay	19	70
shale	33	103
fine black sand	92	195
white clay	9	204

CODED

Coded but not tested.  
TJS

Information upon completion of well:


- (1) Diameter 24 inches.
- (2) Total Depth 181 feet.
- (3) Water Level 43' feet below top of ground.
- (4) Cased to 120', Size 24"
- (5) Screen: Size 12", Length 20'
- (6) Were any formations sealed against pollution?  
X yes, \_\_\_\_\_ no.

If YES depth of formation 120'

Why required

Drillers Remarks:

CODED

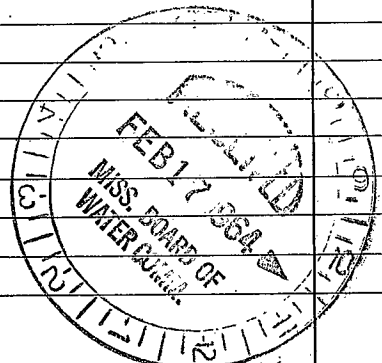

(Use Back Side)

Well No.

⑦