

CODED

Webster
H 20
8-5-69

MISSISSIPPI
BOARD OF WATER COMMISSIONERS
416 North State Street
Jackson, Mississippi 39201

WATER WELL DRILLERS LOG

8-5 1969
date well completed

Charles Lodson Webster
firm name county well located

LANDOWNER:
Robert Belt
Rt 2, Eupora Miss
(mailing address)

description of formations encountered	from	to
Red clay white sand	0	15
	15	133

WELL LOCATION:
sec. 1 T. 17 N R. 10 E
6 miles E of Waltham
(distance) (direction) (nearest town)

WELL PURPOSE: home
(home, irrigation, municipal, industrial)

- WELL COMPLETION DATA:
- (1) diameter (inches) 4"
 - (2) total depth (feet) 124'
 - (3) static water level (feet) 40' below above top of ground.
 - (4) casing Plastic, 124' (material) (depth)
(size) if telescope see back.
 - (5) screen (length) (depth to top)
(size) (material)
 - (6) pump 3/4 (HP) 7 (yield gpm)
Electric (type power)
 - (7) electric log NO (yes or no)
(organization running log)
 - (8) how well bottom plugged Gravel


OCT 6 - 1969

MISS. Bd. of
WATER COMM.

DRILLERS REMARKS:

If well telescopes please sketch and show depths.

GROUND LEVEL

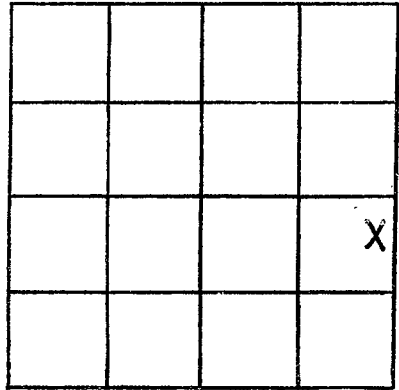

SECTION 1-

Please indicate well location X.

ADDITIONAL INFORMATION

If more than one screen,
show locations of each on sketch.