

Webster  
# 21  
8-7-69

MISSISSIPPI  
 BOARD OF WATER COMMISSIONERS  
 416 North State Street  
 Jackson, Mississippi 39201

CODED

WATER WELL DRILLERS LOG

8-7 1969 Charles L. Latham Webster  
 date well completed firm name county well located


LANDOWNER:	description of formations encountered	from	to
<u>James Crowley</u> <u>Rt 2 Eupora Miss</u> (mailing address)	<u>Red clay</u> <u>white sand</u>	<u>0</u> <u>15</u>	<u>15</u> <u>120</u>
<b>WELL LOCATION:</b>			
sec. <u>1</u> T. <u>17</u> N R. <u>10</u> W <u>6</u> miles <u>E</u> of <u>Waltham</u> (distance) (direction) (nearest town)			
<b>WELL PURPOSE:</b> <u>Home</u> (home, irrigation, municipal, industrial)			
<b>WELL COMPLETION DATA:</b>			
(1) diameter (inches) <u>4"</u>			
(2) total depth (feet) <u>120'</u>			
(3) static water level (feet) <u>40</u> <sup>below</sup> <sub>above</sub> top of ground.			
(4) casing <u>Plastic</u> , <u>120'</u> (material) (depth)			
_____ if telescope see back. (size)			
(5) screen _____ (length) _____ (depth to top)			
(size) _____ (material)			
(6) pump <u>3/4</u> <u>7</u> (HP) (yield gpm)			
<u>Electric</u> (type power)			
(7) electric log _____ (yes or no)			
_____ (organization running log)			
(8) how well bottom plugged <u>Gravel</u>			
<b>DRILLERS REMARKS:</b>			

OCT 6 - 1969

MISS. BD. OF  
 WATER COMM.

If well telescopes please sketch and show depths.

GROUND LEVEL

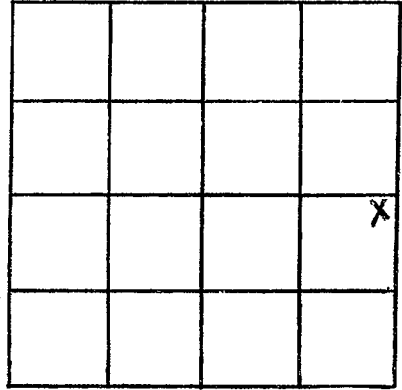

SECTION   /  

Please indicate well location X.

ADDITIONAL INFORMATION

If more than one screen,  
show locations of each on sketch.