

WEBSTER
H 22
10-3-70

MISSISSIPPI
BOARD OF WATER COMMISSIONERS
416 North State Street
Jackson, Mississippi 39201

CODED

WATER WELL DRILLERS LOG

10-3-70 date well completed Charles Rowan firm name Webster county well located

LANDOWNER:
R. L. Johnson
RT 2 Eupora Miss
(mailing address)

description of formations encountered	from	to
Blue Clay	0	40
Blue Shale	40	120
Blue Sand	120	175

WELL LOCATION:
sec. 26 T 20 N R 10 W
5 miles NE of Eupora Miss
(distance) (direction) (nearest town)

WELL PURPOSE: home
(home, irrigation, municipal, industrial)

- WELL COMPLETION DATA:
- (1) diameter (inches) 4"
 - (2) total depth (feet) 175'
 - (3) static water level (feet) 35' below top of ground.
 - (4) casing plastic 120' (material) (depth)
(size) If telescope see back.
 - (5) screen 40' (length) (depth to top)
2 plastic (size) (material)
 - (6) pump 1 (HP) 8 (yield gpm)
Electric (type power)
 - (7) electric log no- (yes or no)

CODED

(organization running log)
(8) how well bottom plugged 2" capped


DRILLERS REMARKS:

NOV 6 - 1970

MISS. BD. OF
WATER COMMISSIONERS

If well telescopes please sketch and show depths.

GROUND LEVEL

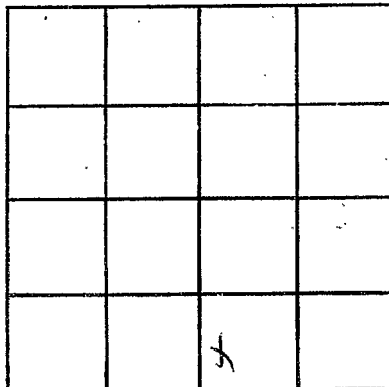

SECTION 26

Please indicate well location X.

ADDITIONAL INFORMATION

If more than one screen,
show locations of each on sketch.