

MISSISSIPPI
BOARD OF WATER COMMISSIONERS
416 North State Street
Jackson, Mississippi 39201

WATER WELL DRILLERS LOG

CODED

HERMAN ECHOLS

Private Well Service
Starkville, Miss.

county well located



WEBSTER
H28
8-71
CODED

date well completed

19 71

Deeg

LANDOWNER:

The Church of Sapa
RFD #2 Box 162 Eureka Miss
(mailing address)

WELL LOCATION:

sec. 36 T. 200 S. R. 10 E. W.
1 miles N of Sapa
(distance) (direction) (nearest town)

WELL PURPOSE:

(home, irrigation, municipal, industrial)

WELL COMPLETION DATA:

- (1) diameter (inches) 5"
- (2) total depth (feet) 126'
- (3) static water level (feet) 40 below above top of ground.
- (4) casing 87' 5" casing
(material) (depth)
(size) If telescope see back.
- (5) screen none
(length) (depth to top)
(size) (material)
- (6) pump 3/4 12
(HP) (yield gpm)
Elc.
(type power)
- (7) electric log (yes or no) _____
(organization running log) _____
- (8) how well bottom plugged _____

Description of formations encountered

from to

<i>Sand Rock with clay</i>	<i>0</i>	<i>87</i>
<i>White Sand</i>	<i>87</i>	<i>115</i>
<i>Pass into white clay</i>	<i>115</i>	<i>126</i>

CODED
CODED

OCT 14 1971


MISS. DEPT. OF
WATER RESOURCES

DRILLERS REMARKS:

*Water seems to have
lots of iron in it.
Plenty of water*

If well telescopes please sketch and show depths.

GROUND LEVEL

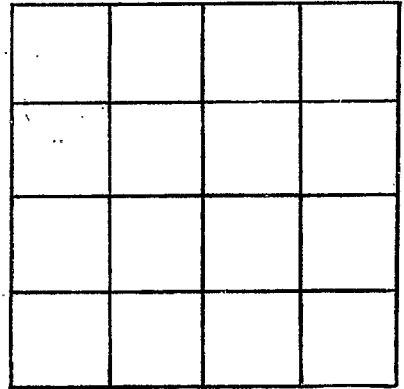

SECTION _____

Please indicate well location X.

ADDITIONAL INFORMATION

If more than one screen, show locations of each on sketch.