

Woburn

H-30

7/16/80

MISSISSIPPI  
BOARD OF WATER COMMISSIONERS  
#52 416 North State Street  
Jackson, Mississippi 39201

CODED

WATER WELL DRILLERS LOG

July 16 1979 Charles Brown Mebert  
date well completed firm name county well located

LANDOWNER: Bobby Newland  
Rt 2  
Europa Min 37744  
(mailing address)

description of formations encountered	from	to
Clay & Sand	0	22
Shell Blue	22	190
Blue Sand & Shell	190	297

WELL LOCATION:  
24 sec. ~~13~~ T. 20 N. R. 10 E.  
S W  
7 miles NE of Europa  
(distance) (direction) (nearest town)

WELL PURPOSE: Home  
(home, irrigation, municipal, industrial)

CODED


- WELL COMPLETION DATA:
- (1) diameter (inches) 2 7/8"
  - (2) total depth (feet) 297
  - (3) static water level (feet) 60 below above top of ground.
  - (4) casing PVC 180  
(material) (depth)  
(size) if telescope see back.
  - (5) screen \_\_\_\_\_  
(length) (depth to top)  
(size) (material)
  - (6) pump 1 5  
(HP) (yield gpm)  
Electric  
(type power)
  - (7) electric log yes  
(yes or no)  
Miss Dept of Natural Resources  
(organization running log)
  - (8) how well bottom plugged open

DRILLERS REMARKS:

DEPT. OF NATURAL RESOURCES  
BUREAU OF LAND & WATER RESOURCES  
AUG 15 1980  
RECEIVED

If well telescopes please sketch and show depths.

GROUND LEVEL

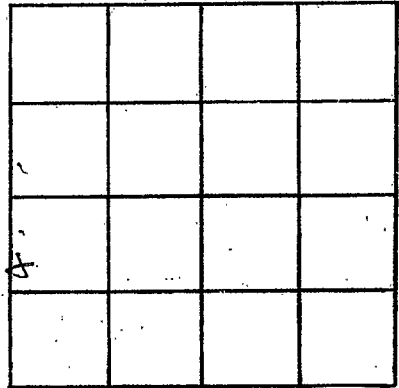

SECTION 13

Please indicate well location X.

ADDITIONAL INFORMATION

If more than one screen, show locations of each on sketch.