

WEBSTER
85
7-72

MISSISSIPPI
 BOARD OF WATER COMMISSIONERS
 416 North State Street
 Jackson, Mississippi 39201

3rd
~~Webster~~

WATER WELL DRILLERS LOG

1972 Sam Smith Webster
 date well completed firm name county well located
Houston MISS.

LANDOWNER: Fred Sewell
Memphis Tenn.
 (mailing address)
 WELL LOCATION:
 sec. 10 T. 22 N. R. 2 E. S. 7
3 miles West of Cumberton
 (distance) (direction) (nearest town)

description of formations encountered	from	to
<u>Silt + Clay</u>	<u>0</u>	<u>100</u>
<u>Blue Gray</u>	<u>100</u>	<u>200</u>
<u>Reddish clay</u>	<u>200</u>	<u>1100</u>
<u>Black shale</u>	<u>1100</u>	<u>1200</u>
<u>Reddish + silt</u>	<u>1200</u>	<u>1350</u>
<u>White sand</u>	<u>1350</u>	<u>1575</u>

WELL PURPOSE: home
 (home, irrigation, municipal, industrial)


WELL COMPLETION DATA:
 (1) diameter (inches) 4
 (2) total depth (feet) 1600
 (3) static water level (feet) 315 below top of ground.
 (4) casing Steel 400
 (material) (depth)
2 if telescope see back.
 (size)
 (5) screen open
 (length) (depth to top)
 (size) (material)
 (6) pump 1 10
 (HP) (yield gpm)
Electric
 (type power)
 (7) electric log NO
 (yes or no)
 (organization running log)

JUL 1970
 MISSISSIPPI
 WATER

(8) how well bottom plugged _____
 DRILLERS REMARKS:

If well telescopes please sketch and show depths.

GROUND LEVEL

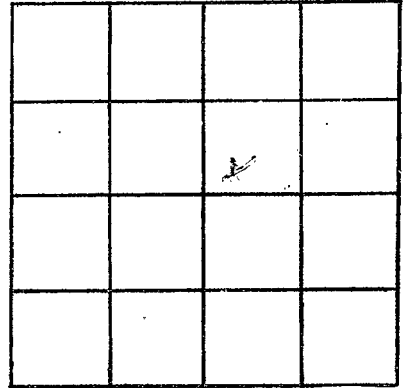

SECTION 103

Please indicate well location X.

ADDITIONAL INFORMATION

If more than one screen, show locations of each on sketch.