

J 12

10-11-63

WATER WELL DRILLERS LOG

CODE 21

Date: 10/11, 1963, Driller: Baley Drilling Co County: Washington
(Name)

(1) Owner of Land: Town of Mathiston
(Name)
Mathiston
(Address)

(2) Location: 3 19N 11E
at Mathiston
miles (distance) direction (Nearest Town) of

(3) Topography: Hilly
(Hilly) (Flat) (Level)

(4) Purpose of Well: Municipal
(Domestic Irrigation) (Municipal, Industrial, Other)

Description & Color of Materials Sand, Clay, Red Clay, Shell, etc.	Thick- ness Feet	Depth Feet
<u>Clay</u>		<u>6</u>
<u>Sand</u>		<u>37</u>

Coded by W. J. ...
 Located 4-11-63

Information upon completion of well:

(1) Diameter 6 inches.

(2) Total Depth 37 feet.

(3) Water Level 10 feet below top of ground.

(4) Cased to all way, Size 6.


(5) Screen: Size 6, Length 24.

(6) Were any formations sealed against pollution?
 _____ yes, X no.

If YES depth of formation _____

Why _____

Drillers Remarks: _____

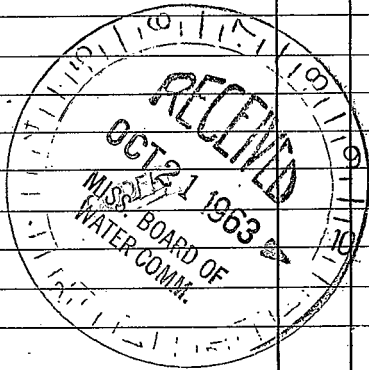

(Use Back Side)

Well No.

18