


Webster
 J 2000
 7-15-75

MISSISSIPPI
 BOARD OF WATER COMMISSIONERS
 416 North State Street
 Jackson, Mississippi 39201

WATER WELL DRILLERS LOG

July 15 1975 Charles Kovorn Webster
 date well completed firm name county well located


LANDOWNER: Bobby Peacock Maben Miss.	description of formations encountered	from	to
(mailing address)	Blue shell Blue shell + Blue SAND MIX	0 40	40 110
WELL LOCATION:			
sec. 35 T 20 N R 11 E 2 miles N of Maben Miss. (distance) (direction) (nearest town)			
WELL PURPOSE: Home (home, irrigation, municipal, industrial)			
WELL COMPLETION DATA:			
(1) diameter (inches) 4"			
(2) total depth (feet) 110'			
(3) static water level (feet) 60' below top of ground.			
(4) casing plastic 110' (material) (depth)			
(size) if telescope see back.			
(5) screen 60' 50' (length) (depth to top)			
4" gravel packed (size) (material)			
(6) pump 1/2 5 gal (HP) (yield/gpm)			
electric (type power)			
(7) electric log yes (yes or no)			
(organization running log)			
(8) how well bottom plugged Graded			
DRILLERS REMARKS:			

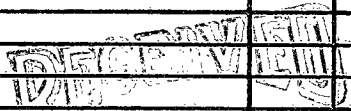

MISS. BD. OF WATER COMMISSIONERS

If well telescopes please sketch and show depths.

GROUND LEVEL

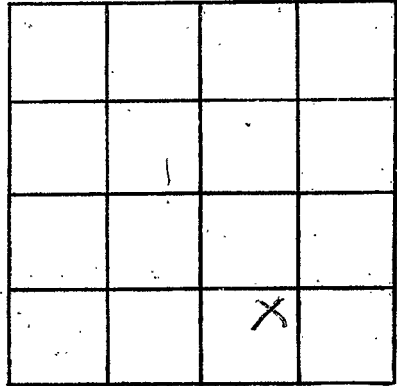

SECTION _____

Please indicate well location X.

ADDITIONAL INFORMATION

If more than one screen, show locations of each on sketch.