

Webster  
 RA  
 5-10-68  
 M.G.S.  
 5-10

MISSISSIPPI  
 BOARD OF WATER COMMISSIONERS  
 416 North State Street  
 Jackson, Mississippi 39201

CODED

WATER WELL DRILLERS LOG

date well completed 19 68 Herndon, Hornum, Welford, Webster  
 firm name Inc.  
 county well located

LANDOWNER: Cumberland  
 Water Association  
 Webster Co., Miss.  
 (mailing address)

description of formations encountered	from	to
Red Clay	0	18
Light Blue clay	18	65
Dark Blue clay	65	455
White Chalk (Shale of sand)	455	920
Blue clay (gummy)	920	1720
Water sand	1720	1830
Sand (ree gravel)	1830	1883
Bottom	1883	

WELL LOCATION:  
 sec. 6 T 20 N R 12 E  
 SE 1/4 NW 1/4  
 (distance) miles (direction) of (nearest town)

WELL PURPOSE: COMMUNITY  
 (home, irrigation, municipal, industrial)

WELL COMPLETION DATA:  
 (1) diameter (inches) 8"  
 (2) total depth (feet) 1883  
 (3) static water level (feet) 224' below top of ground.  
 (4) casing Steel, 1008' (material) (depth)  
 8" (size) If telescope see back.  
 (5) screen 421, 982 (length) (depth to top)  
 4" (size) 304 stainless steel (material)  
 (6) pump 25 (HP) 150 (yield gpm)  
 electric (type power) USGS clay #17  
 (7) electric log Yes (yes for no)  
 Min. Meter Co. Survey (organization running log)  
 (8) how well bottom plugged

DRILLERS REMARKS:

APR 30 1968

MISS. BD. OF WATER COMM.

If well telescopes please sketch and show depths.

K4

GROUND LEVEL




1068  
9 8" CASING

Lead  
Seal

4" CASING

42' 8"  
4" SCREEN

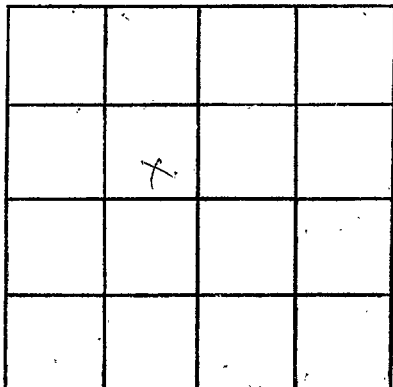

SECTION 6

Please indicate well location X.

ADDITIONAL INFORMATION

A series of horizontal lines providing space for additional information.

If more than one screen, show locations of each on sketch.