

WEBSTER  
K8

9-66

MISSISSIPPI BOARD OF WATER COMMISSIONERS

CODED

WATER WELL DRILLERS LOG

Date: Sept 21, 1966, Driller: Herdon-Homan Well & Supply, Inc. Webster  
(When well drilled) P. O. Box 42 County Clay  
SEANNON, MISSISSIPPI 38908 (Where well is located)

(1) Owner of Land: Mary Shields  
(Name)  
RT 2 Mabon Miss.  
(Address)  
(2) Location: SW 1/4, SW 1/4, Sec 21 T 20N R 12E  
2 1/2 miles NE of Mabon  
(distance) (direction) (Nearest Town)  
(3) Topography: Hilly  
(Hilly) (Flat) (Level)  
(4) Purpose of Well: Home  
(Domestic Irrigation  
Municipal, Industrial, Other)


Description & Color of Materials Sand, Clay, Red Clay, Shell, etc.	Thick- ness Feet	Depth Feet
<u>surface sand</u>		
<u>clay</u>	<u>0</u>	<u>60</u>
<u>blue silt</u>	<u>60</u>	<u>300</u>
<u>blue clay</u>	<u>300</u>	<u>600</u>
<u>blue silt</u>	<u>600</u>	<u>1080</u>
<u>sand</u>	<u>1080</u>	<u>1200</u>

CODED

Information upon completion of well:

(1) Diameter 4 inches.  
(2) Total Depth 1200 feet.  
(3) Water Level 315 feet below top of ground.  
413' 8" 4"  
(4) Cased to 798', Size 2"  
1211  
(5) Screen: Size none, Length \_\_\_\_\_  
(6) Were any formations sealed against pollution?  
1 yes, \_\_\_\_\_ no.

If YES depth of formation 300'  
Why surface & sand  
Drillers Remarks: \_\_\_\_\_  
Yield in gpm: 5  
Size pump: 3/4  
Type power: electric

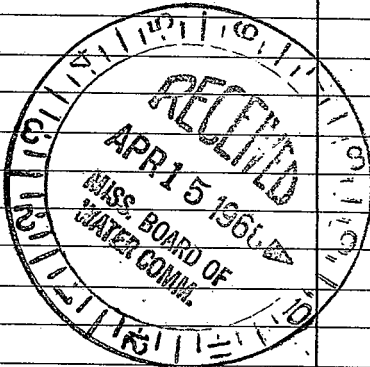

Mail this copy to Board of Water Commissioners 429 Miss. St. Jackson, Miss.

[The page contains extremely faint and illegible text, likely bleed-through from the reverse side of the document. The text is scattered across the page and cannot be transcribed accurately.]