

WEBSTER

K9

4-66

MISSISSIPPI BOARD OF WATER COMMISSIONERS

WATER WELL DRILLERS LOG

CODED Webster

Date: April 24 1966, Driller: Homan-Homan Well & Supply, Inc. P. O. Box 42, County: Webster, MISSISSIPPI 39368


(1) Owner of Land: Charles Hargrave (Name) Rt 2 Pheba, Miss. (Address)
(2) Location: NE 1/4, NW 1/4, Sec. 27 T 20N R 12W 3 miles NE of Moxee (distance) (direction) (Nearest Town)
(3) Topography: rolling (Hilly) (Flat) (Level)
(4) Purpose of Well: Domestic (Domestic Irrigation Municipal, Industrial, Other)

Table with 3 columns: Description & Color of Materials, Thickness Feet, Depth Feet. Rows include: surface sand + clay (0-60), Blue Rock (60-300), White Chalk (300-600), Blue Rock (600-1000), Sand (1000-1125), Bottom (1125)

Information upon completion of well:

(1) Diameter 4 inches.
(2) Total Depth 1125 feet.
(3) Water Level 200 feet below top of ground.
(4) Cased to 405' 4", Size 4"
(5) Screen: Size Down, Length 163'
(6) Were any formations sealed against pollution? yes, no.

If YES depth of formation 300'
Why surface & sand
Drillers Remarks:
Yield in gpm: 5
Size pump: 3/4
Type power: Electric

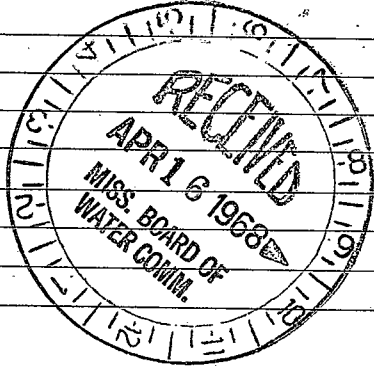

12/1/1914

St. Louis, Mo.

Dear Mr. [Name]

I have your letter of [Date]

and am glad to hear

from you. I am

very busy at present

but will get to you

as soon as possible.

Very truly yours,

[Signature]

[Name]

[Address]

[City, State]

[Country]

[Phone Number]

[Telex Number]

[Fax Number]

[E-mail Address]

[Web Address]

[Social Media]

[Other Contact Info]