

WEBSTER  
K13

MISSISSIPPI DEPARTMENT OF NATURAL RESOURCES  
Bureau of Land and Water Resources  
Southport Mall  
P.O. Box 10631  
Jackson, Mississippi 39209  
WATER WELL DRILLERS LOG

CODED

5-12-97 19  
date well completed

Parks + Parks  
firm name

Webster  
county well located

LANDOWNER: Tim Roberson

RT 2 Box 782

Maben, MS 39750  
(mailing address)

WELL LOCATION:

sec. 6 T. 17<sup>20</sup> S. R. 2<sup>12</sup> E. of Cumberland  
(distance) miles (direction) (nearest town)

WELL PURPOSE:

(home, irrigation, municipal, industrial)

WELL COMPLETION DATA:

- (1) diameter (inches) 6x3
- (2) total depth (feet) 1320
- (3) static water level (feet) 247 below top of ground.
- (4) casing Steel, 567,  
(material) (depth)  
6"  
(size) if telescope see back.
- (5) screen 60', 1260'  
(length) (depth to top)  
3, STAINLESS  
(size) (material)
- (6) pump 10 80  
(HP) (yield gpm)  
ELECTRIC  
(type power)
- (7) electric log NO  
(yes or no)  
  
(organization running log)
- (8) how well bottom plugged RPV

description of formations encountered

from

to

CLAY + Limestone	0	810
CLAY + Rock	810	860
CLAY Limestone	860	995
Brown CLAY + Rock	995	1015
CLAY	1015	1075
Silty SAND + Clay	1075	1115
Brown CLAY	1115	1175
CLAY + SAND	1175	1235
Rock + SAND	1235	1255
SAND	1255	1280
SAND	1280	1335

RECEIVED



MAY 16 1997

Dept. of Environmental Quality  
Office of Land & Water Resources

DRILLERS REMARKS:

If well telescopes please sketch and show depths.

GROUND LEVEL

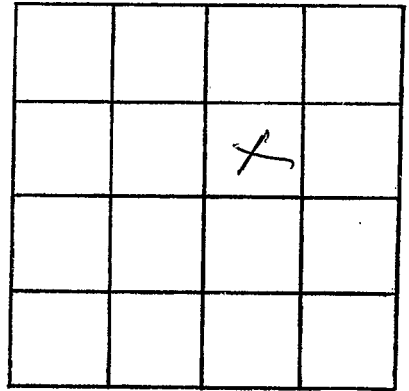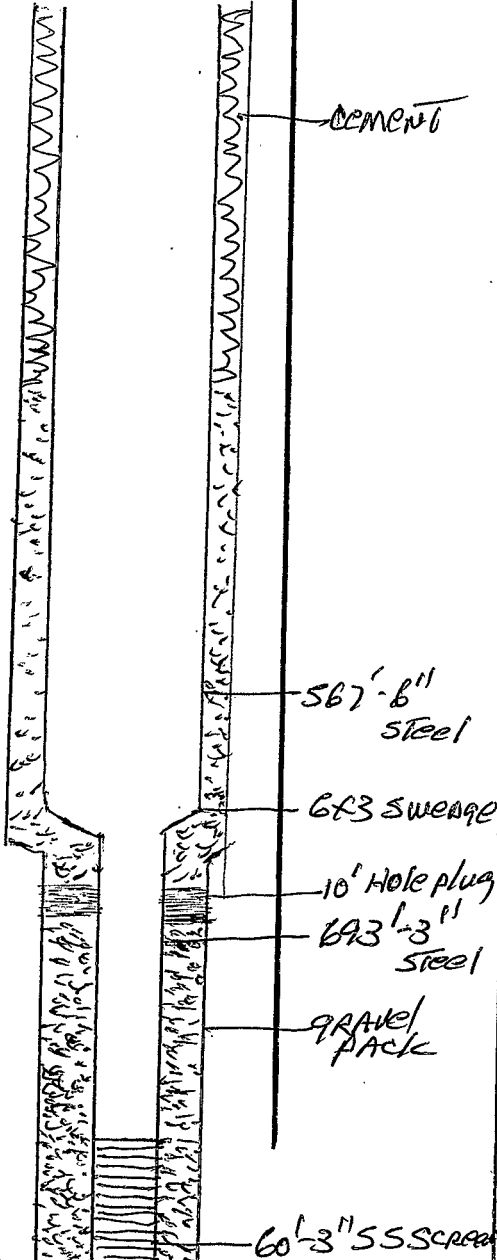

SECTION 6

Please indicate well location X.

ADDITIONAL INFORMATION

Multiple horizontal lines provided for additional information.

TD  
1320

If more than one screen, show locations of each on sketch.