

P.L. BLAKE

MISSISSIPPI
BOARD OF WATER COMMISSIONERS
416 North State Street
Jackson, Mississippi 39201

DOED

WATER WELL DRILLERS LOG

Webster

L 1

11-68

11-15

date well completed

19 LEBRASWELL DRLY CO

firm name

Webster

county well located

LANDOWNER: MARK FARMS

description of formations encountered

from

to

600'

Red Clay

0 - 43

Hard Rock

50

Bentonite

80

MISS
(mailing address)

Hard shale

126

WELL LOCATION:

NE, 1/4

Rock

140

sec. 5 T. 19 N R. 8 E
4 miles E of Lock
(distance) (direction) (nearest town)

Shale rock

155

Shale

340

Hard Rock

380

hard layer & green shale

500

WELL PURPOSE: Home
(home, irrigation, municipal, industrial)

Black shale

580

Sand

620

WELL COMPLETION DATA:

(1) diameter (inches) 2"

(2) total depth (feet) 620

(3) static water level (feet) 72 below
top of ground.

(4) casing METAL, 620 500
(material) (depth)

(size) If telescope see back.

(5) screen WOLF 500
(length) (depth to top)

(size) (material)

(6) pump 1 HP 15 GPM
(HP) (yield gpm)

5 1/2 hp (USGS catalog # 19)

(7) electric log yes
(yes or no)

W S Mason
(organization running log)

(8) how well bottom plugged


DRILLERS REMARKS:

NOV 25 1968

MISS. BD. OF
WATER COMM.

If well telescopes please
sketch and show depths.

GROUND LEVEL

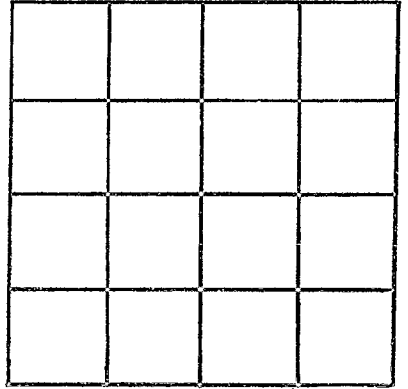

SECTION _____

Please indicate well location X.

ADDITIONAL INFORMATION

If more than one screen,
show locations of each on sketch.