



If well telescopes please sketch and show depths.

SOLID

GROUND LEVEL


315' - 4" GALV  
CASING

SOLID

115' - 2" GALV.  
CASING

SOLID

30' - 2" STAIN-  
LESS STEEL  
SCREEN

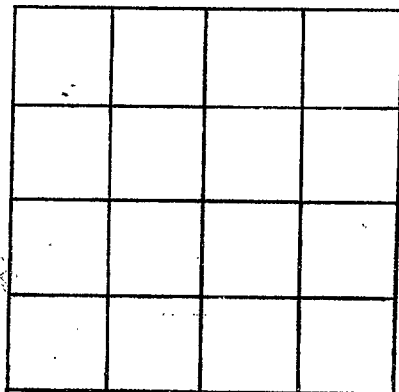

SECTION 4

Please indicate well location X.

ADDITIONAL INFORMATION

If more than one screen,  
show locations of each on sketch.