

WEBSTER  
~~45~~ L6  
 1-1-73

MISSISSIPPI  
 BOARD OF WATER COMMISSIONERS  
 416 North State Street  
 Jackson, Mississippi 39201 **CODED**

WATER WELL DRILLERS LOG

Open 1973 Charles L. Brown Webster  
 date well completed firm name county well located

LANDOWNER: William Bright  
 Stewart Miss  
 (mailing address)

description of formations encountered.	from	to
Red Clay	0	30
Blue Shale	30	50
Brownish Grey Sand	40	132

WELL LOCATION:  
 sec 23 T 19 N R 4 E  
 3 miles N of Stewart  
 (distance) (direction) (nearest town)

WELL PURPOSE: Home  
 (home, irrigation, municipal, industrial)

WELL COMPLETION DATA:

(1) diameter (inches) 4"  
 (2) total depth (feet) 132'  
 (3) static water level (feet) 50 below top of ground.  
 (4) casing Plastic, 130; (material) (depth)  
 (size) If telescope see back.  
 (5) screen (length) (depth to top)  
 (size) (material)  
 (6) pump 1 (HP) 6 (yield gpm)  
 Electric (type power)  
 (7) electric log No (yes or no)  
 (organization running log)  
 (8) how well bottom plugged Gravel


**CODED**

DRILLERS REMARKS:

AUG 6 1973

If well telescopes please sketch and show depths.

GROUND LEVEL

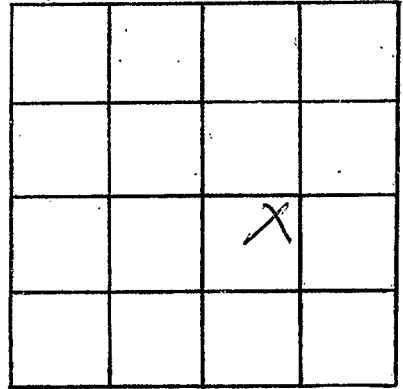

SECTION 23

Please indicate well location X.

ADDITIONAL INFORMATION

If more than one screen,  
show locations of each on sketch.