

Webster
L8
9/85

MISSISSIPPI DEPARTMENT OF NATURAL RESOURCES
Bureau of Land and Water Resources
 Southport Mall
 P.O. Box 10631
 Jackson, Mississippi 39209
WATER WELL DRILLERS LOG

CODED

9-15 1985 date well completed Herridon Well & Supply, Inc. Webster firm name county well located

LANDOWNER: Stewart Water Association, P. O. Box 29
 Stewart, MS 39767
 (mailing address)

description of formations encountered	from	to
Red Clay	0	10
Coarse Red & White Sand	10	80
Blue Clay w/Sand Streaks	80	255
Sand	255	277
Blue Sandy Clay	277	375
Rock 4-inch	375	375
Blue Clay	375	400
Rock 2-inch		400
Blue Clay w/Clay Streaks	400	455
Blue Clay, Few Sand Streaks	455	605
Sand	605	650
Blue Clay	650	705

WELL LOCATION:
 sec. 35 T 19 N R 8 E
 SX WK
 2 miles North of Stewart
 (distance) (direction) (nearest town)

WELL PURPOSE: Municipal
 (home, irrigation, municipal, industrial)

WELL COMPLETION DATA:

- (1) diameter (inches) 10 x 6"
- (2) total depth (feet) 651'
- (3) static water level (feet) 141' below top of ground.
- (4) casing Steel, 610' (material), (depth)
 10" if telescope see back. (size)
- (5) screen 41'2" 609' (length), (depth to top)
 6" SS Ribbed (size), (material)
- (6) pump 25 272 (HP), (yield gpm)
 Electric (type power)
- (7) electric log yes (yes or no)
 Herndon Well (organization running log)
- (8) how well bottom plugged 6" BWV

CODED

RECEIVED



OCT 16 1985

DRILLERS REMARKS:

Department of Natural Resources
 Bureau of Land & Water Resources

If well telescopes please sketch and show depths.

GROUND LEVEL

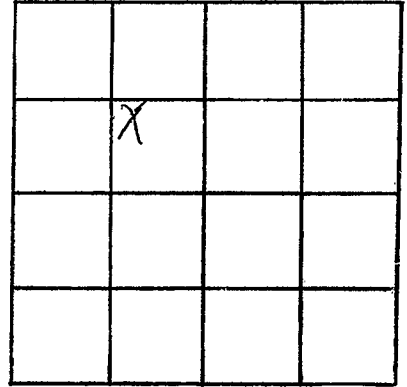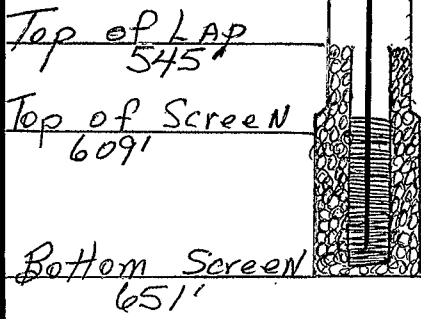

SECTION 35

Please indicate well location X.

ADDITIONAL INFORMATION

If more than one screen, show locations of each on sketch.