

L 11  
12-14-60

WATER WELL DRILLERS LOG

L CODED 0

Date: 12-14, 1960, Driller: Smith & Prady County Webster  
(Name)

(1) Owner of Land: Mr. M. K. Hood  
(Name)  
P. J. Stewart  
(Address)  
(2) Location: W 1/4 SW 1/4, Sec 30 T9R8  
7 miles S. W. of Stewart  
(distance) (direction) (Nearest Town)  
(3) Topography: flat  
(Hilly) (Flat) (Level)  
(4) Purpose of Well: domestic  
(Domestic Irrigation  
Municipal, Industrial, Other)


Description & Color of Materials Sand, Clay, Red Clay, Shell, etc.	Thick- ness Feet	Depth Feet
Yellow clay	20	20
Sand and pebbles		
Clay mixed	18	38
broken clay	41	79
brown clay with		
sand and black		
shales like bit	5	84
blue clay	40	124
hard part	1	125
blue clay	26	151
course sand	1	152
blue clay	58	210
granite	3	213
silt white	29	242

Information upon completion of well:

(1) Diameter 2 inches.  
(2) Total Depth 238 feet.  
(3) Water Level 25 feet below top of ground.  
(4) Cased to 147, Size 2  
(5) Screen: Size non, Length \_\_\_\_\_  
(6) Were any formations sealed against pollution?  
\_\_\_\_\_ yes, X no.

If YES depth of formation \_\_\_\_\_  
Why \_\_\_\_\_

Drillers Remarks: No sand  
plenty of good water

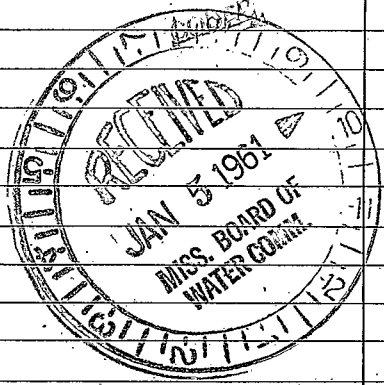

(Use Back Side)

Well No. 9

