

Webster  
L 13  
10-67

MISSISSIPPI  
BOARD OF WATER COMMISSIONERS  
416 North State Street  
Jackson, Mississippi 39201

CODED

WATER WELL DRILLERS LOG

10-25 1967 Charles Rovern Webster  
date well completed firm name county well located

LANDOWNER: Lale Johnson

description of formations encountered

from to

Zommolen Miss

Red clay	0	15
Shale	15	85
light blue sand	85	140

(mailing address)

WELL LOCATION:

sec. 13 T. 19 N. R. 8 E  
3 miles NW of Zommolen  
(distance) (direction) (nearest town)

WELL PURPOSE: Home  
(home, irrigation, municipal, industrial)

WELL COMPLETION DATA:

(1) diameter (inches) 4"

(2) total depth (feet) 140'

(3) static water level (feet) 40' below top of ground.

(4) casing Plexic, 140'  
(material) (depth)

\_\_\_\_\_ if telescope see back.  
(size)

(5) screen \_\_\_\_\_  
(length) (depth to top)

\_\_\_\_\_ (size) \_\_\_\_\_ (material)

(6) pump 3/4 4  
(HP) (yield/gpm)

Electric  
(type power)

(7) electric log no  
(yes or no)

\_\_\_\_\_ (organization running log)

(8) how well bottom plugged graveled

DRILLERS REMARKS:

CODED

CODED


CODED

CODED

APR 18 1968  
INST. DEPT. OF  
WATER CONTROL

If well telescopes please sketch and show depths.

GROUND LEVEL

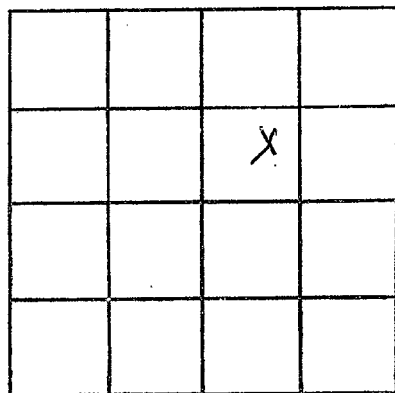

SECTION 13

Please indicate well location X.

ADDITIONAL INFORMATION

If more than one screen,  
show locations of each on sketch.