

CODED

MISSISSIPPI
BOARD OF WATER COMMISSIONERS
416 North State Street
Jackson, Mississippi 39201

WATER WELL DRILLERS LOG

Webster
L 14
11-67

11-20 1967 Charles Lovern Webster
 date well completed firm name county well located

LANDOWNER: Ollie Mitchell
Zemolen, Miss.
 (mailing address)

description of formations encountered	from	to
Clay	0	14
white sand	14	118

WELL LOCATION:
 sec. 25 T. 19 N. R. 8 E.
2 miles W of Zemolen
 (distance) (direction) (nearest town)

WELL PURPOSE: Home
 (home, irrigation, municipal, industrial)

- WELL COMPLETION DATA:
- (1) diameter (inches) 4"
 - (2) total depth (feet) 118'
 - (3) static water level (feet) below
top of ground.
 - (4) casing Plastic, 118'
(material) (depth)
 - if telescope see back.
(size)
 - (5) screen /
(length) (depth to top)
 - /
(size) (material)
 - (6) pump 1/2 / 4
(HP) (yield gpm)
 - Electric
(type power)
 - (7) electric log No.
(yes or no)
 - (organization running log)
 - (8) how well bottom plugged gravel

DRILLERS REMARKS:

CODED


CODED

CODED



If well telescopes please sketch and show depths.

GROUND LEVEL

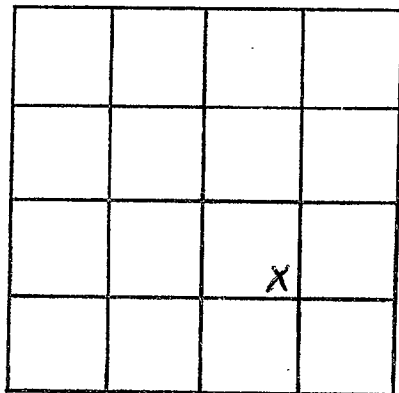

SECTION 25

Please indicate well location X.

ADDITIONAL INFORMATION

If more than one screen,
show locations of each on sketch.