

CODING

WEBSTER  
L 15  
2-68

MISSISSIPPI  
BOARD OF WATER COMMISSIONERS  
416 North State Street  
Jackson, Mississippi 39201

CODING

WATER WELL DRILLERS LOG

2-16-68 19 Thomas & Son Webster  
date well completed firm name county well located

LANDOWNER: Mr. Noel Barnett  
Kilmichel, Miss.  
Lives In Indenola, Miss.  
(mailing address)


WELL LOCATION:  
sec 30 T 19 N 8 E 5  
S W  
5 miles NW of Stewart  
(distance) (direction) (nearest town)

WELL PURPOSE:  
(home) irrigation, municipal, industrial

WELL COMPLETION DATA:

- (1) diameter (inches) 2
- (2) total depth (feet) 465
- (3) static water level (feet) 18 <sup>(below)</sup> <sub>above</sub> top of ground.
- (4) casing Galv. 357  
(material) (depth)  
2" if telescope see back.  
(size)
- (5) screen none  
(length) (depth to top)  
open  
(size) (material)
- (6) pump 1 10  
(HP) (yield gpm)  
elec  
(type power)
- (7) electric log No  
(yes or no)
- (8) how well bottom plugged \_\_\_\_\_  
(organization running log)


description of formations encountered	from	to
Red CLAY	0	3
CHALK	3	15
Black dirt	15	53
CHALKY SAND	53	63
Fine Sand little	63	100
CHALK		
Pure Coarse Sand	100	150
Stks SAND & CHALK	150	160
Soft Grey Chalk	160	192
Rock 4"	192	
Hard Black dirt	192	208
Stks Rock & Black	208	243
dirt About 5'		
Between Rocks		
Hard Rock 4" Thick	243	
Blue CHALK	244	281
Fine SAND	281	284
Blue CHALK	284	294
Stks Rock & Black	294	320
Dirt		
Blue CHALK	320	360
Fine Grey SAND	360	377
Rock & CHALK	377	383
Grey Green SAND	383	465

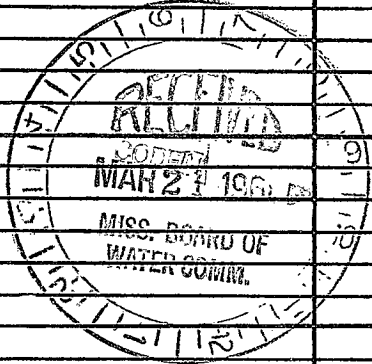

DRILLERS REMARKS:

If well telescopes please sketch and show depths.

GROUND LEVEL

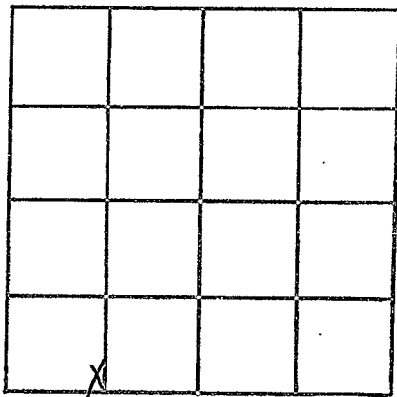

SECTION 30

Please indicate well location X.

ADDITIONAL INFORMATION

If more than one screen,  
show locations of each on sketch.