

Webster
L 19
4-10-70

MISSISSIPPI
BOARD OF WATER COMMISSIONERS
416 North State Street
Jackson, Mississippi 39201

WATER WELL DRILLERS LOG

4-10 1970 Charles Lovarr Webster
date well completed firm name county well located

LANDOWNER:	description of formations encountered	from	to
Burd Stewart Miss (mailing address)	Red Clay Red + white sand mixed	0	44
WELL LOCATION: sec. 26 T. 19 N. R. 8 E. 081 2 miles N of Stewart (distance) (direction) (nearest town)			
WELL PURPOSE: home (home, irrigation, municipal, industrial)			
WELL COMPLETION DATA: (1) diameter (inches) 4" (2) total depth (feet) 110 (3) static water level (feet) 44 (below) above top of ground. (4) casing Plastic, 110 (material) (depth) (size) If telescope see back. (5) screen (length) (depth to top) (size) (material) (6) pump 3/4 (HP) 5 (yield gpm) Electric (type power) (7) electric log no (yes or no) (organization running log) (8) how well bottom plugged Grouted			


MAY 11 1970

MISS. BD. OF
WATER COMM.

DRILLERS REMARKS:

If well telescopes please sketch and show depths.

GROUND LEVEL

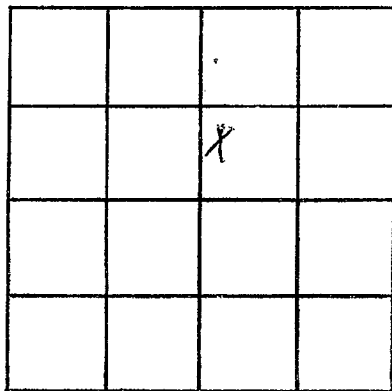

SECTION 26

Please indicate well location X.

ADDITIONAL INFORMATION

A series of horizontal lines for writing additional information.

If more than one screen, show locations of each on sketch.