

Webster
 L 2000
 9/21/81

MISSISSIPPI
 BOARD OF WATER COMMISSIONERS
 416 North State Street
 Jackson, Mississippi 39201

WATER WELL DRILLERS LOG

9-21-81 date well completed THOMAS firm name Webster county well located

LANDOWNER: Lodi Humling
Clear
6 mi. N of Stewart
 (mailing address)

description of formations encountered	from	to
Red clay	0	10
All SAND	10	130

WELL LOCATION:
 sec. 4 T. 19 N. R. 30 E
6 miles N of Stewart
 (distance) (direction) (nearest town)

WELL PURPOSE:
 (home, irrigation, municipal, industrial)

- WELL COMPLETION DATA:
- (1) diameter (inches) 2
 - (2) total depth (feet) 130
 - (3) static water level (feet) 100 ^{below} top of ground.
 - (4) casing Pvc, 120
 (material) (depth)
2 if telescope see back.
 (size)
 - (5) screen 10, 120
 (length) (depth to top)
10 1/2, 2" 10 slot Pvc
 (size) (material)
 - (6) pump 1, 5
 (HP) (yield gpm)
Elec
 (type power)
 - (7) electric log N
 (yes or no)


(organization running log)
 (8) how well bottom plugged Point

DRILLERS REMARKS: North of Stewart

DEPT. OF NATURAL RESOURCES
 BUREAU OF LAND & WATER RESOURCES
 DEC 28 1981
 RECEIVED

If well telescopes please sketch and show depths.

GROUND LEVEL

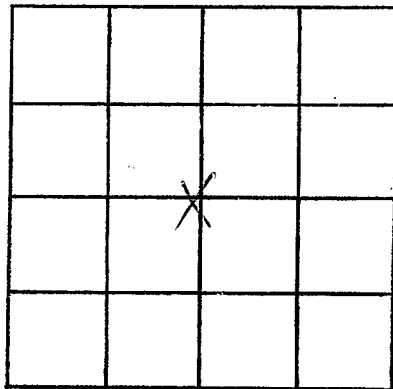

SECTION 64

Please indicate well location X.

ADDITIONAL INFORMATION

If more than one screen,
show locations of each on sketch.