

Webster
M-2
7/8/71

MISSISSIPPI
 BOARD OF WATER COMMISSIONERS
 416 North State Street
 Jackson, Mississippi 39201

WATER WELL DRILLERS LOG

July 18 1971 Charles Lovan Webster
 date well completed firm name county well located


LANDOWNER:	description of formations encountered	CODED	from	to
<u>James Hemphill</u> <u>Zamalek, Miss</u> (mailing address)	<u>Red clay</u> <u>Blue Shale</u> <u>Blue Sand</u>	<u>0</u> <u>40</u> <u>120</u> <u>180</u>		
WELL LOCATION: sec. <u>7</u> T. <u>19</u> N. R. <u>9</u> E. <u>6</u> miles <u>N.W.</u> of <u>Zamalek</u> (distance) (direction) (nearest town)				
WELL PURPOSE: <u>Home</u> (home, irrigation, municipal, industrial)				
WELL COMPLETION DATA: (1) diameter (inches) <u>4"</u> (2) total depth (feet) <u>180</u> (3) static water level (feet) <u>50</u> <u>below</u> top of ground. (4) casing <u>plastic</u> , <u>120'</u> (material) (depth) (size) if telescope see back. (5) screen _____ (length) (depth to top) (size) (material) (6) pump <u>1</u> <u>8</u> (HP) (yield gpm) <u>Electric</u> (type power) (7) electric log <u>no</u> (yes or no) (organization running log) (8) how well bottom plugged <u>knocked</u>		CODED		
DRILLERS REMARKS:				

SEP 7 1971

MISS. Bd. OF
 WATER COMMISSIONERS

If well telescopes please sketch and show depths.

GROUND LEVEL

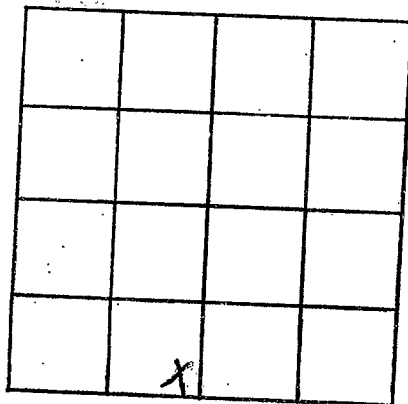

SECTION 7

Please indicate well location X.

ADDITIONAL INFORMATION

If more than one screen, show locations of each on sketch.