

WEBSTER

M8

11/75

Flag # 45

November

19

75 Herndon Well & Supply, Inc.

CODED

WATER WELL DRILLERS LOG

Well No. 15

Webster

date well completed

firm name

county well located

LANDOWNER: Town of Eupora

City Hall

Eupora, MS

(mailing address)

WELL LOCATION:

sec 15 T 19 N R 9 E

Town of Eupora

miles (distance) of (direction) (nearest town)

WELL PURPOSE: Municipal (home, irrigation, municipal, industrial)

WELL COMPLETION DATA:

- (1) diameter (inches) 10 x 6
- (2) total depth (feet) 340
- (3) static water level (feet) 46 below top of ground
- (4) casing Steel 252' (material) (depth) 10" (size) If telescope see back.
- (5) screen 90' (length) 250 (depth to top) 6" (.030) Stainless Steel (size) (material)
- (6) pump 40 (HP) 335 (yield gpm) Elec. (type power)
- (7) electric log yes (yes or no) USGS (organization running log)
- (8) how well bottom plugged 6" BWV

description of formations encountered

from

to

Red Clay 0 25

Blue rock 25 75

Sand 75 127

rock 127 129

Sand 129 180

Gray Clay 180 250

Sand 250 380

Blue Clay 380 420

CODED


DRILLERS REMARKS:

11/21/75
11/21/75
11/21/75
1975 - 2 1976

MISS. BD. OF WATER COMMISSIONERS

If well telescopes please sketch and show depths.

GROUND LEVEL

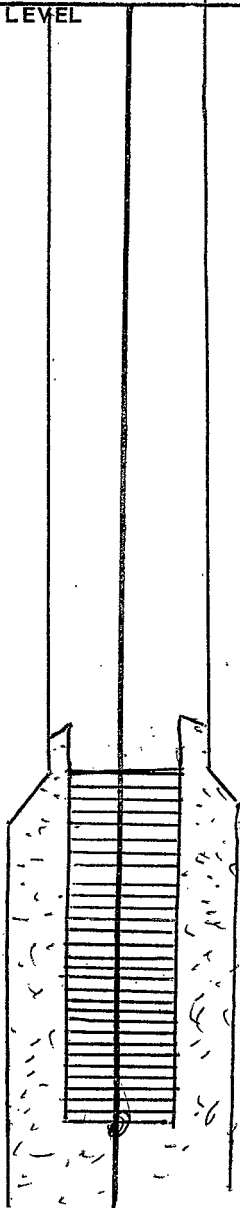

If more than one screen, show locations of each on sketch.

SECTION 15

Please indicate well location X.

ADDITIONAL INFORMATION

STATIC WL 46'

PUMPING WL 125'

DD 79'

GRAVEL PACK: # 10-30
8 CORD