


Webster
M10
9-10-68

MISSISSIPPI
BOARD OF WATER COMMISSIONERS
416 North State Street
Jackson, Mississippi 39201

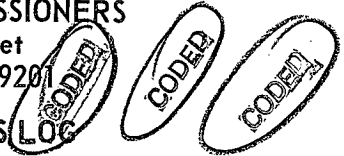

WATER WELL DRILLERS LOG

9-10 1968 Charles Loren Webster
date well completed firm name county well located

LANDOWNER: Mrs. Zeshie Cameron

description of formations encountered	from	to
	Clay Gypsum	0 20

Cameron
Eupora Miss.
(mailing address)

WELL LOCATION:

sec. 15 T-19 N R-9 E
S W
5 miles NE of Zamosa
(distance) (direction) (nearest town)

WELL PURPOSE: Home
(home, irrigation, municipal, industrial)

WELL COMPLETION DATA:

- (1) diameter (inches) 4
- (2) total depth (feet) 130
- (3) static water level (feet) 30 below top of ground, above
- (4) casing Plastic 130
(material) (depth)

_____ If telescope see back.
(size)
- (5) screen _____
(length) (depth to top)

_____ (size) _____ (material)
- (6) pump 3/4 _____
(HP) (yield gpm)
Electric
(type power)
- (7) electric log no
(yes or no)

_____ (organization running log)
- (8) how well bottom plugged gravel

T-19 N

DRILLERS REMARKS:

SEP 21 1968

MISS. BD. OF
WATER COM.

If well telescopes please sketch and show depths.

GROUND LEVEL

			X

SECTION ~~10~~ 15

Please indicate well location X.

ADDITIONAL INFORMATION

If more than one screen, show locations of each on sketch.