

WEBSTER
M 13
7-67

MISSISSIPPI
BOARD OF WATER COMMISSIONERS
416 North State Street
Jackson, Mississippi 39201

CODED

WATER WELL DRILLERS LOG

8-20-80 19-67 Charles Lorraine Webster
date well completed firm name county well located

LANDOWNER: James Pogue

description of formations encountered

from to

Zemolen Miss
(mailing address)

Clay
Shale
Red Sand
White Sand

0 10
10 40
40 70
70 100

WELL LOCATION:

sec. 17 T. 19 S. R. 9 W.
1 1/2 miles N Zemolen
(distance) (direction) (nearest town)

WELL PURPOSE:

(home, irrigation, municipal, industrial)

WELL COMPLETION DATA:

- (1) diameter (inches) 4"
- (2) total depth (feet) 100'
- (3) static water level (feet) 45' below top of ground.
- (4) casing Plastic, 4" (material) (depth)

(size) if telescope see back.

- (5) screen (length) (depth to top)

(size) (material)

- (6) pump 1 (HP) 600 mi (yield gpm)

Electric (type power)

- (7) electric log (yes or no)

(organization running log)

- (8) how well bottom plugged gravel


DRILLERS REMARKS:

JUN 17 1968

MISS. BD. OF WATER COMMS

If well telescopes please sketch and show depths.

GROUND LEVEL

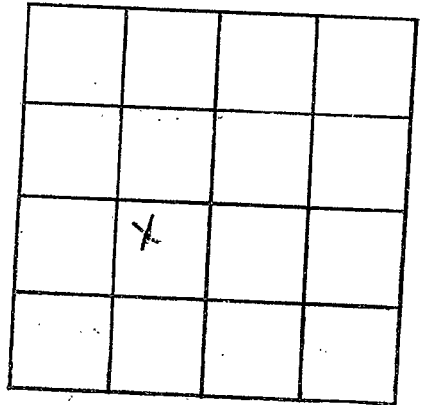

SECTION 19 SW

Please indicate well location X.

ADDITIONAL INFORMATION

If more than one screen,
show locations of each on sketch.