

CODED

Webster  
M14  
11-607

MISSISSIPPI  
BOARD OF WATER COMMISSIONERS CODED  
416 North State Street  
Jackson, Mississippi 39201

WATER WELL DRILLERS LOG

11-6 1967 Charles Lovorn Webster  
date well completed firm name county well located

LANDOWNER: Pete Marler  
Zemolen Miss  
(mailing address)

description of formations encountered	from	to
White Clay	0	40
Shale	40	220
Blue Sand	220	300

WELL LOCATION:  
sec. 8 T. 19 N R. 9 E  
3 miles NW of Zemolen Miss  
(distance) (direction) (nearest town)

WELL PURPOSE: Home  
(home, irrigation, municipal, industrial)

WELL COMPLETION DATA:

- (1) diameter (inches) 4"
- (2) total depth (feet) 300'
- (3) static water level (feet) 80' <sup>below</sup> top of ground
- (4) casing Plaster 160' (material) (depth)  
if telescope see back. (size)
- (5) screen \_\_\_\_\_ (length) \_\_\_\_\_ (depth to top)  
(size) (material)
- (6) pump 3/4 (HP) 5 (yield gpm)  
Electric (type power)
- (7) electric log no (yes or no)  
(organization running log)
- (8) how well bottom plugged Open


CODED

MISS. BOARD OF WATER COMMISSIONERS

DRILLERS REMARKS:

If well telescopes please sketch and show depths.

GROUND LEVEL

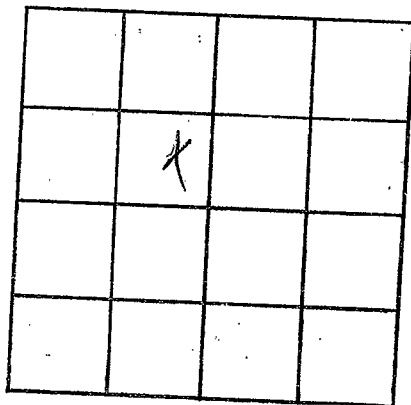

SECTION 8

Please indicate well location X.

ADDITIONAL INFORMATION

If more than one screen, show locations of each on sketch.