

Webster
M15
12-67

MISSISSIPPI
BOARD OF WATER COMMISSIONERS
416 North State Street
Jackson, Mississippi 39201

~~CODED~~

WATER WELL DRILLERS LOG

12-1 1967 Charles Lovern Webster
date well completed firm name county well located

LANDOWNER:

Jung Box
Jennolan Miss
(mailing address)

description of formations encountered

from to

White Clay 0 20
Shale 20 90
Sand 90 132

WELL LOCATION:

sec 29 T 19 N R 9 E
S W
1 miles W of Jennolan
(distance) (direction) (nearest town)

WELL PURPOSE: Home
(home, irrigation, municipal, industrial)

WELL COMPLETION DATA:

- (1) diameter (inches) 4"
- (2) total depth (feet) 132'
- (3) static water level (feet) 30' ^{below} top of ground
- (4) casing Plastic 80' (material) (depth)
- (size) if telescope see back.
- (5) screen (length) (depth to top)
- (size) (material)
- (6) pump 3/4 (HP) 6 (yield gpm)
- Electric (type power)
- (7) electric log no (yes or no)
- (organization running log) Open
- (8) how well bottom plugged Grouted


~~CODED~~

MISS. BOARD OF WATER COMMISSIONERS
JUL 18 1967

DRILLERS REMARKS:

If well telescopes please sketch and show depths.

GROUND LEVEL

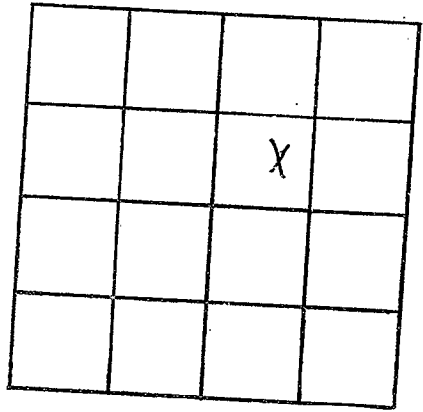

SECTION _____

Please indicate well location X.

ADDITIONAL INFORMATION

If more than one screen, show locations of each on sketch.