

Webster  
M16  
5-9-69

MISSISSIPPI  
 BOARD OF WATER COMMISSIONERS  
 416 North State Street  
 Jackson, Mississippi 39201

WATER WELL DRILLERS LOG

5-9 1969 Charles Loden Webster  
 date well completed firm name county well located

LANDOWNER:  
Billie Joe Starnord  
Rt - Europa Miss  
 (mailing address)

description of formations encountered	from	to
<u>Red Clay</u>	<u>0</u>	<u>15</u>
<u>Blue Shell</u>	<u>15</u>	<u>246</u>
<u>Blue Sand</u>	<u>246</u>	<u>266</u>

WELL LOCATION:  
 sec. 9 T. 19 N R. 9 E  
5 miles NE of Zemelen  
 (distance) (direction) (nearest town)

WELL PURPOSE: Home  
 (home, irrigation, municipal, industrial)

- WELL COMPLETION DATA:
- (1) diameter (inches) 4"
  - (2) total depth (feet) 266'
  - (3) static water level (feet) 112 <sup>below</sup> above top of ground.
  - (4) casing Plastic 160'  
 (material) (depth)  
 \_\_\_\_\_ if telescope see back.  
 (size)
  - (5) screen \_\_\_\_\_ (length) \_\_\_\_\_ (depth to top)  
 (size) (material)
  - (6) pump 3/4 4  
 (HP) (yield gpm)  
Charles  
 (type power)
  - (7) electric log NO  
 (yes or no)  
 \_\_\_\_\_ (organization running log)
  - (8) how well bottom plugged Open


DRILLERS REMARKS:

JUN 4 1969

MISS. BD. OF  
 WATER COMM.

If well telescopes please sketch and show depths.

GROUND LEVEL

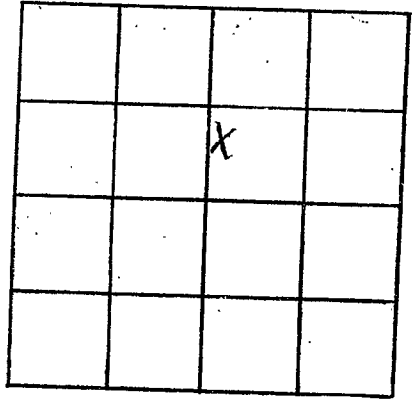

SECTION 9NE

Please indicate well location X.

ADDITIONAL INFORMATION

Lined area for additional information.

If more than one screen, show locations of each on sketch.