

Webster
M17
5-16-69

MISSISSIPPI
BOARD OF WATER COMMISSIONERS
416 North State Street
Jackson, Mississippi 39201

WATER WELL DRILLERS LOG

5-16 1969 Charles Gordon Webster
date well completed firm name county well located

LANDOWNER:
W.P. Lechman
Zomolen Miss
(mailing address)

description of formations encountered	from	to
Red clay	0	15
Blue sandstone	15	70
Blue sand	70	132

WELL LOCATION:
sec. 28 T 19 N R 9 E
S 3 W
intown miles of Zomolen
(distance) (direction) (nearest town)

WELL PURPOSE: Home
(home, irrigation, municipal, industrial)

- WELL COMPLETION DATA:
- (1) diameter (inches) 4"
 - (2) total depth (feet) 132'
 - (3) static water level (feet) 29' (below/above top of ground)
 - (4) casing Plastic, 40' (material) (depth)
 - (size) If telescope see back.
 - (5) screen (length) (depth to top)
 - (size) (material)
 - (6) pump 1/2 (HP) 6 (yield gpm)
 - Electric (type power)
 - (7) electric log No. (yes or no)
 - (organization running log)
 - (8) how well bottom plugged Open.


JUN 4 1969

MISS. BD. OF WATER COMMISSIONERS

DRILLERS REMARKS:

If well telescopes please sketch and show depths.

GROUND LEVEL

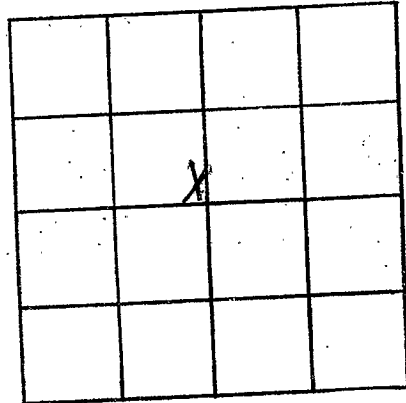

SECTION 28 NE

Please indicate well location X.

ADDITIONAL INFORMATION

If more than one screen,
show locations of each on sketch.